

MW-25

WATER WELL PLUGGING RECORD Form WWC-5P KSA 82a-1212 ID NO.

1 LOCATION OF WATER WELL: County: Johnson Fraction 1/4 SW 1/4 NW 1/4 SE 1/4 Section Number 30 Township Number T 13 S Range Number 24 [X] E [] W

Street/Rural Address of Well Location; if unknown, distance & direction from nearest town or intersection: If at owner's address, check here [] 400 North Rogers Rd., Olathe, KS

Global Positioning Systems (GPS) information:

Latitude: 38.8901 (in decimal degrees)

Longitude: 94.78433 (in decimal degrees)

Elevation:

Datum: [X] WGS84, [] NAD83, [] NAD27

Collection Method:


[X] GPS unit (Make/Model: Garmin Etrek

[] Digital Map/Photo, [] Topographic Map, [] Land Survey

Est. Accuracy: [] < 3 m, [X] 3-5 m, [] 5-15 m, [] > 15 m

2 WATER WELL OWNER: Honeywell International RR#, St. Address, Box #: 23500 W. 105th St. City, State ZIP Code: Olathe, KS 66061

3 MARK WELL'S LOCATION WITH AN "X" IN SECTION BOX:

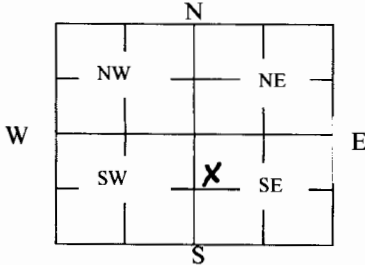

4 DEPTH OF WELL 12 ft.

WELL'S STATIC WATER LEVEL 2.4 ft

WELL WAS USED AS:

- [] Domestic
[] Irrigation
[] Feedlot
[] Industrial

- [] Public Water Supply
[] Oil Field Water Supply
[] Domestic (Lawn & Garden)
[] Air Conditioning

- [X] Dewatering
[X] Monitoring MW-25
[] Injection Well
[] Other

Was a chemical/bacteriological sample submitted to Department? Yes [] No [X]

5 TYPE OF BLANK CASING USED:

- [X] Steel [] RMP (SR) [] Wrought [] Fiberglass [] Other (Specify below)
[X] PVC [] ABS [] Asbestos-Cement [] Concrete Tile

Blank casing diameter 2 in. Was casing pulled? Yes [X] No [] If yes, how much 7 feet
Casing height above or below land surface -3 in.

6 GROUT PLUG MATERIAL: [] Neat cement [] Cement grout [X] Bentonite [] Other

Grout Plug Intervals: From 12 ft. to 3 ft., From ___ ft. to ___ ft., From ___ to ___ ft.

What is the nearest source of possible contamination:

- [] Septic tank [] Seepage pit [] Fuel Storage [] Other (specify below)
[] Sewer lines [] Pit privy [] Fertilizer storage
[] Watertight sewer lines [] Sewage lagoon [] Insecticide storage
[] Lateral lines [] Feedyard [] Abandoned water well Direction from well?
[] Cess pool [] Livestock pens [] Oil well/Gas well How many feet?

Table with columns: FROM, TO, PLUGGING MATERIALS. Row 1: 12, 3, High Solids Bentonite. Row 2: 3, 0, Topsoil.

7 CONTRACTOR'S OR LANDOWNER'S CERTIFICATION: This water well was plugged under my jurisdiction and was completed on (mo/day/year) 4/2/2018 and this record is true to the best of my knowledge and belief. Kansas Water Well Contractor's License No. 710. This Water Well Record was completed on (mo/day/year) 4/11/2018 under the business name of Below Ground Surface, Inc. by (signature)

INSTRUCTIONS: Use typewriter or ballpoint pen. Please press firmly and print clearly. Please fill in blanks, underline or circle the correct answers. Send top three copies to Kansas Department of Health and Environment, Bureau of Water, Geology Section, 1000 SW Jackson St., Ste. 420, Topeka, Kansas 66612-1367. Telephone: 785/296-5524. Send one to Water Well Owner and retain one for your records. Visit us at http://www.kdheks.gov/waterwell/index.html.

Check one: [] White Copy [] Blue Copy [] Pink Copy