


USE TYPEWRITER OR BALL POINT PEN-PRESS FIRMLY, PRINT CLEARLY.

WATER WELL RECORD  
KSA 82a-1201-1215

Kansas Department of Health and Environment-Division of Environment  
(Water well Contractors)  
Topeka, Kansas 66620

1. Location of well: County **Johnson** Fraction **SE NE NW SW 1/4 1/4 1/4** Section number **31** Township number **13s** Range number **25e**

2. Distance and direction from nearest town or city: **2 mi. NW of Stanley, Ks.**  
Street address of well location if in city:  
3. Owner of well: **Pacer Oil Co.**  
R.R. or street: **1019 Burlington**  
City, state, zip code: **N. Kansas City, Mo. 64116**

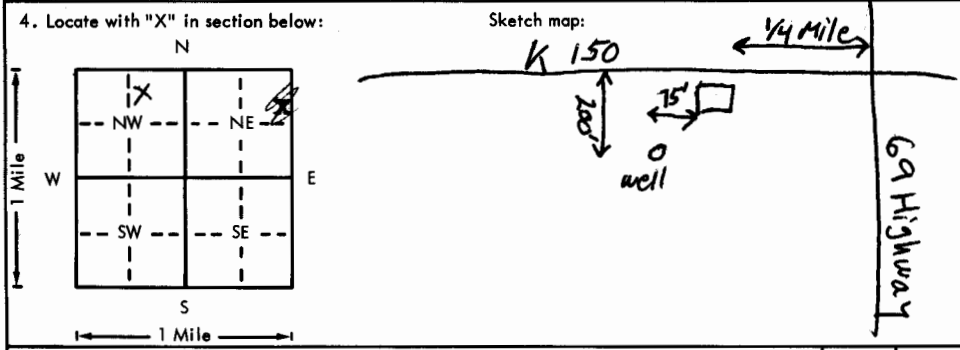

6. Bore hole dia. **7-8** in. Completion date **6/19/78**  
Well depth **205** ft.  
7.  Cable tool  Rotary  Driven  Dug  
 Hollow rod  Jetted  Bored  Reverse rotary  
8. Use:  Domestic  Public supply  Industry  
 Irrigation  Air conditioning  Stock  
 Lawn  Oil field water  Other  
9. Casing: Material **PVC** Height: Above or below  
Threaded  Welded  Surface **12** in.  
RMP  PVC Weight **1.75** lbs./ft.  
Dia. **5** in. to **205** ft. depth Wall Thickness: inches or  
Dia.  in. to  ft. depth gage No. **sec. 200**

5. Type and color of material	From	To
fill	0	7
broken line (yellow)	7	10
line (grey)	10	23
shale (grey)	23	28
line (grey)	28	34
shale (green)	34	37
shale (red)	37	48
shale (grey)	48	49
line (grey)	49	54
shale (grey)	54	57
line (grey)	57	65
shale (grey-green)	65	102
lime (grey)	102	105
shale (grey)	105	112
line (grey)	112	118
shale (grey)	118	120
line (grey)	120	142
shale (black)	142	148
line (grey)	148	168
shale (grey)	168	170
line (grey)	170	190
shale (grey)	190	205

10. Screen: Manufacturer's name **Jess and Lowell**  
Type **PVC** Dia. **5"**  
Slot/gauge **drill/slot** Length **102"**  
Set between **2 190** ft. and **180** ft.  
 ft. and  ft.  
Gravel pack?  Size range of material **1/8"**  
11. Static water level: **80** mo./day/yr.  
**80** ft. below land surface Date **6/19/78**  
12. Pumping level below land surfaces:  
 ft. after  hrs. pumping  g.p.m.  
 ft. after  hrs. pumping  g.p.m.  
Estimated maximum yield **40 gal per hour**  
13. Water sample submitted:  Yes  No Date  
14. Well head completion:  
 Pitless adapter **12** inches above grade  
15. Well grouted?   
With:  Neat cement  Bentonite  Concrete  
Depth: From **155** ft. to **155** ft. **ALSO 35'**  
to **5'**  
16. Nearest source of possible contamination:  
ft. **100** Direction **East** Type **septic**  
Well disinfected upon completion?  Yes  No  
17. Pump: Not installed  
Manufacturer's name **Gould's**  
Model number **7EH** HP **3/4** Volts **230**  
Length of drop pipe **187** ft. capacity **7** g.p.m.  
Type:  
 Submersible  Turbine  
 Jet  Reciprocating  
 Centrifugal  Other

18. Elevation: **930'**  
Topography:  
 Hill  
 Slope  
 Upland  
 Valley  
19. Remarks:  
**Customer is aware of state regulation to install a 4 foot square concrete platform around well.**  
**X Steven D. Cox**

20. Water well contractor's certification:  
This well was drilled under my jurisdiction and this report is true to the best of my knowledge and belief.  
**F.E. Young Drilling Co. 240**  
Business address: **6355 Robinhood Ln.** License No.  
Address  
Signed **David Young** Date **6/19/78**  
Authorized representative

T 13 250 W 31 SE NE NE 1/4 1/4 1/4