


LOCATION OF WATER WELL:	Fraction	Section Number	Township Number	Range Number
County: Johnson	SE ¼ SE ¼ SE ¼	33	T 13 S	R 25

Distance and direction from nearest town or city street address of well if located within city?
75' west of Mission Rd., 90' north of 95th St. MW-5

2] WATER WELL OWNER: Phillips 66 Marketing Division
RR#, St. Address, Box # : P. O. Box 2400
City, State, ZIP Code : Bartlesville, Oklahoma 74005

LOCATE WELL'S LOCATION WITH AN "X" IN SECTION BOX:	4	DEPTH OF COMPLETED WELL	15.5	ft.	ELEVATION:	
--	---	-------------------------	------	-----	------------	--

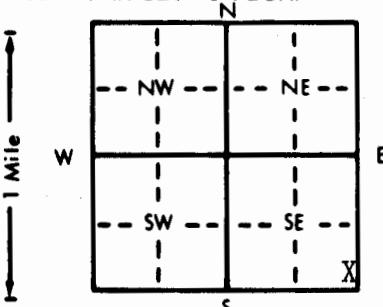

4 DEPTH OF COMPLETED WELL. 15.5 ft. ELEVATION: _____
Depth(s) Groundwater Encountered 1. None ft. 2. _____ ft. 3. _____ ft.

WELL'S STATIC WATER LEVEL ft. below land surface measured on mo/day/yr

Pump test data: Well water was ft. after hours pumping gpm

Est. Yield gpm: Well water was ft. after hours pumping gpm

Bore Hole Diameter 8 in. to 15.5 ft. and _____ in. to _____ ft.

WELL WATER TO BE USED AS: 5 Public water supply 8 Air conditioning 11 Injection well

1 Domestic	3 Feedlot	6 Oil field water supply	9 Dewatering	12 Other (Specify below)
------------	-----------	--------------------------	--------------	--------------------------

2 Irrigation 4 Industrial 7 Lawn and garden only **10 Monitoring well** 12 Other (Specify below)

Was a chemical/bacteriological sample submitted to Department? Yes.....No X.....; If yes, mo/day/yr sample was sub

5	TYPE OF BLANK CASING USED:	5 Wrought iron	8 Concrete tile	CASING JOINTS: Glued	Clamped
---	----------------------------	----------------	-----------------	--------------------------------	-------------------

1 Steel	3 RMP (SR)	6 Asbestos-Cement	9 Other (specify below)	Welded
2 PVC	4 ABS	7 Fiberglass		Threaded. <u>X</u>

Blank casing diameter 2 in. to 5.5 ft., Dia in. to ft., Dia in. to ft.

Casing height above land surface. -1 in., weight 3 lbs./ft. Wall thickness or gauge No. 40
TYPE OF SCREEN OR PERFORATION MATERIAL: 3 PVC 10. Asbestos cement

TYPE OF SCREEN OR PERFORATION MATERIAL:

1 Steel	3 Stainless steel	5 Fiberglass	8 RMP (SR)	10 Asbestos-cement	11 Other (specify)
---------	-------------------	--------------	------------	--------------------	--------------------------

2 Brass	4 Galvanized steel	6 Concrete tile	9 ABS	12 None used (open hole)
---------	--------------------	-----------------	-------	--------------------------

SCREEN OR PERFORATION OPENINGS ARE:	5 Gauzed wrapped	8 Saw cut	11 None (open hole)
1 Continuous slot	6 Wire wrapped	9 Drilled holes	
2 Mill slot			

1 Continuous slot 3 Mill slot 6 Wire wrapped 9 Drilled holes
2 Louvered shutter 4 Key punched 7 Torch cut 10 Other (specify)

SCREEN-PERFORATED INTERVALS: From . . . 15.5 . . . ft. to . . . 5.5 . . . ft., From ft. to ft.

	From ft. to ft.	From ft. to ft.
GRAVEL BACK INTERVALS	From 15.5 ft. to 3.5 ft.	From 5 ft. to 1.5 ft.

GRAVEL PACK INTERVALS: From . . . 15.5 ft. to . . . 31.5 ft., From ft. to ft.
From ft. to ft., From ft. to ft.

6 GROUT MATERIAL: 1 Neat cement 2 Cement grout 3 Bentonite 4 Other Concrete 0-2'

Grout intervals: From 3.5 ft. to 2 ft., From ft. to ft., From ft. to ft.

What is the nearest source of possible contamination:

1 Sptic tank	4 Lateral lines	7 Pit privy	10 Livestock pens	14 Abandoned water well
			11 Fuel storage	15 Oil well/Gas well

2 Sewer lines	5 Cess pool	8 Sewage lagoon	12 Fertilizer storage	16 Other (specify below)
---------------	-------------	-----------------	-----------------------	--------------------------

3 Watertight sewer lines	6 Seepage pit	9 Feedyard	13 Insecticide storage	
--------------------------	---------------	------------	------------------------	-------

Direction from well? East		How many feet? 21	
FROM	TO	LITHOLOGIC LOG	PLUGGING INTERVALS

[illegible]

7. CONTRACTOR'S OR LANDOWNER'S CERTIFICATION: This water well was (1) constructed, (2) reconstructed, or (3) plugged under my jurisdiction and was completed on (mo/day/year) 7/19/93 and this record is true to the best of my knowledge and belief. Kansas Water Well Contractor's License No. 510 This Water Well Record was completed on (mo/day/yr) 8/2/93 under the business name of MIKON Corporation by (signature) David J. Keame