

1 LOCATION OF WATER WELL: County: <u>JOHNSON</u>	Fraction <u>SW 1/4 SE 1/4 NW 1/4</u>	Section Number <u>33</u>	Township Number T <u>13</u> S	Range Number R <u>250</u> EW
---	---	-----------------------------	----------------------------------	---------------------------------

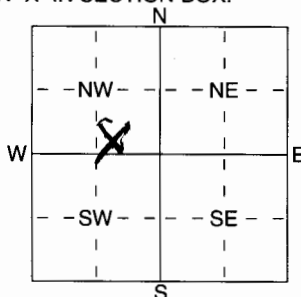
Distance and direction from nearest town or city street address of well if located within city?

8904 RED BUD LANE, LENEXA, KS.2 WATER WELL OWNER: DEAN & JULIE STENABAUGHRR#, St. Address, Box # : 8904 RED BUD LANECity, State, ZIP Code : LENEXA, KS. 66220

Board of Agriculture, Division of Water Resources

Application Number: _____

3 LOCATE WELL'S LOCATION WITH AN "X" IN SECTION BOX:

4 DEPTH OF COMPLETED WELL 204 ft. ELEVATION: _____Depth(s) Groundwater Encountered 1 ft. 2 ft. 3 ft.

WELL'S STATIC WATER LEVEL _____ ft. below land surface measured on mo/day/yr _____

Pump test data: Well water was _____ ft. after _____ hours pumping _____ gpm

Est. Yield _____ gpm Well water was _____ ft. after _____ hours pumping _____ gpm

WELL WATER TO BE USED AS: 5 Public water supply 8 Air conditioning 11 Injection well

1 Domestic 3 Feedlot 6 Oil field water supply 9 Dewatering 12 Other (Specify below)

2 Irrigation 4 Industrial 7 Domestic (lawn & garden) 10 Monitoring well GEOTHERMALWas a chemical/bacteriological sample submitted to Department? Yes _____ No X; If yes, mo/day/yr sample was submittedWater Well Disinfected? Yes _____ No X

5 TYPE OF BLANK CASING USED:

- 1 Steel
2 PVC
3 RMP (SR)
4 ABS

- 5 Wrought iron
6 Asbestos-Cement
7 Fiberglass

- 8 Concrete tile
9 Other (specify below)

- CASING JOINTS: Glued _____ Clamped _____
Welded X
Threaded _____

Blank casing diameter 3/4 in. to 204 ft., Dia _____ in. to _____ ft., Dia _____ in. to _____ ft.Casing height above land surface 48 in., weight _____ lbs./ft. Wall thickness or gauge No. SDR11

TYPE OF SCREEN OR PERFORATION MATERIAL:

- 1 Steel
2 Brass
3 Stainless Steel
4 Galvanized Steel

- 5 Fiberglass
6 Concrete tile

- 7 PVC
8 RMP (SR)
9 ABS

- 10 Asbestos-Cement
11 Other (Specify)
12 None used (open hole)

SCREEN OR PERFORATION OPENINGS ARE:

- 1 Continuous slot
2 Louvered shutter
3 Mill slot
4 Key punched

- 5 Gauzed wrapped
6 Wire wrapped
7 Torch cut

- 8 Saw cut
9 Drilled holes
10 Other (specify) _____ ft.
11 None (open hole)

SCREEN-PERFORATED INTERVALS: From _____ ft. to _____ ft., From _____ ft. to _____ ft.

GRAVEL PACK INTERVALS: From _____ ft. to _____ ft., From _____ ft. to _____ ft.

6 GROUT MATERIAL:

1 Neat cement

2 Cement grout

3 Bentonite

4 Other _____

Grout intervals: From 4 ft. to 204 ft., From _____ ft. to _____ ft., From _____ ft. to _____ ft.

What is the nearest source of possible contamination:

- 1 Septic tank
2 Sewer lines
3 Watertight sewer lines
4 Lateral lines
5 Cess pool
6 Seepage pit

- 7 Pit privy
8 Sewage lagoon
9 Feedyard

- 10 Livestock pens
11 Fuel storage
12 Fertilizer storage
13 Insecticide storage
14 Abandoned water well
15 Oil well/Gas well
16 Other (specify below) HOUSE

Direction from well?

WESTHow many feet? 15

FROM	TO	LITHOLOGIC LOG	FROM	TO	PLUGGING INTERVALS
0	9	CLAY			
9	30	LIMESTONE			
30	37	SHALE GRAY			
37	61	LIMESTONE			
61	91	SHALE GRAY			
91	116	LIMESTONE			
116	125	SHALE GRAY			
125	142	LIMESTONE			
142	154	SHALE GRAY TO RED			
154	177	LIMESTONE			
177	181	SHALE GRAY			
181	183	LIMESTONE			
183	187	SHALE GRAY			
187	204	LIMESTONE			

4 holes to 2047 CONTRACTOR'S OR LANDOWNER'S CERTIFICATION: This geothermal well was (1) constructed, (2) reconstructed, or (3) plugged under my jurisdiction and wascompleted on (mo/day/year) 5/18/05 and this record is true to the best of my knowledge and belief. KansasWater Well Contractor's Licence No 760 This Water Well Record was completed on (mo/day/yr) 6/13/05under the business name of ASSOCIATED DRILLING CO. by (signature) [Signature]