WATER WELL RECORD Form WWC-5 KSA 82a-1212 ID No. _____

1 LOCATION OF WATER WELL: County: JOHNSON	Fraction: NW ¼ NW ¼ NW ¼	Section Number: 16	Township Number: T 13 S	Range Number: R 25 E/W

Distance and direction from nearest town or city street address of well if located within city?
13901 HOWE DR, LEAWOOD, KS.

2 WATER WELL OWNER: TIM CURRY
RR#, St. Address, Box # : 6704 W. 146th PL, APT. 3902
City, State, ZIP Code : OVERLAND PARK, KS. 66223

Board of Agriculture, Division of Water Resources Application Number: —

3 LOCATE WELL'S LOCATION WITH AN "X" IN SECTION BOX:

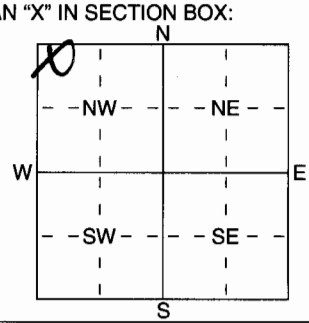

4 DEPTH OF COMPLETED WELL 180 ft. ELEVATION: —

Depth(s) Groundwater Encountered 1 — ft. 2 — ft. 3 — ft.
WELL'S STATIC WATER LEVEL — ft. below land surface measured on mo/day/yr —
Pump test data: Well water was — ft. after — hours pumping — gpm
Est. Yield — gpm: Well water was — ft. after — hours pumping — gpm

WELL WATER TO BE USED AS: 1 Domestic 2 Irrigation 3 Feedlot 4 Industrial 5 Public water supply 6 Oil field water supply 7 Domestic (lawn & garden) 8 Air conditioning 9 Dewatering 10 Monitoring well 11 Injection well 12 Other (Specify below) CLOSED LOOP GEOTHERMAL

Was a chemical/bacteriological sample submitted to Department? Yes ..... No X; If yes, mo/day/yrs sample was submitted
Water Well Disinfected? Yes ..... No X

5 TYPE OF BLANK CASING USED: 1 Steel 2 PVC 3 RMP (SR) 4 ABS 5 Wrought iron 6 Asbestos-Cement 7 Fiberglass 8 Concrete tile 9 Other (specify below) HDPE

CASING JOINTS: Glued ..... Clamped ..... Welded X Threaded .....

Blank casing diameter 3/4 in. to 180 ft., Dia — in. to — ft., Dia — in. to — ft.
Casing height above land surface 60 in., weight — lbs./ft. Wall thickness or guage No SDR11

TYPE OF SCREEN OR PERFORATION MATERIAL: 1 Steel 2 Brass 3 Stainless Steel 4 Galvanized Steel 5 Fiberglass 6 Concrete tile 7 PVC 8 RMP (SR) 9 ABS 10 Asbestos-Cement 11 Other (Specify) 12 None used (open hole)

SCREEN OR PERFORATION OPENINGS ARE: 1 Continuous slot 2 Louvered shutter 3 Mill slot 4 Key punched 5 Guazed wrapped 6 Wire wrapped 7 Torch cut 8 Saw cut 9 Drilled holes 10 Other (specify) 11 None (open hole)

SCREEN-PERFORATED INTERVALS: From — ft. to — ft., From — ft. to — ft.
From — ft. to — ft., From — ft. to — ft.
GRAVEL PACK INTERVALS: From — ft. to — ft., From — ft. to — ft.
From — ft. to — ft., From — ft. to — ft.

6 GROUT MATERIAL: 1 Neat cement 2 Cement grout 3 Bentonite 4 Other .....
Grout Intervals: From 3 ft. to 180 ft., From — ft. to — ft., From — ft. to — ft.

What is the nearest source of possible contamination:
1 Septic tank 2 Sewer lines 3 Watertight sewer lines 4 Lateral lines 5 Cess pool 6 Seepage pit 7 Pit privy 8 Sewage lagoon 9 Feedyard 10 Livestock pens 11 Fuel storage 12 Fertilizer storage 13 Insecticide storage 14 Abandoned water well 15 Oil well/Gas well 16 Other (specify below) HOUSE
Direction from well? WEST How many feet? 22

FROM	TO	LITHOLOGIC LOG	FROM	TO	PLUGGING INTERVALS
0	3	SOIL	175	180	SHALE, GRAY
3	5	LIMESTONE			
5	27	SHALE, ORANGE TO GRAY			
27	35	LIMESTONE			
35	59	SHALE, GRAY TO RED TO GRAY			
59	65	LIMESTONE			
65	72	SHALE, GRAY			3 - 180
72	79	LIMESTONE			3 - 170
79	115	SHALE, GRAY			3 - 160
115	119	LIMESTONE			
119	126	SHALE, GRAY			
126	150	LIMESTONE			
150	168	SHALE, GRAY			
168	175	LIMESTONE			

7 CONTRACTOR'S OR LANDOWNER'S CERTIFICATION: This GEOTHERMAL well was (1) constructed, (2) reconstructed, or (3) plugged under my jurisdiction and was completed on (mo/day/year) 1/3/06 and this record is true to the best of my knowledge and belief. Kansas Water Well Contractor's Licence No 760 This Water Well Record was completed on (mo/day/yr) 2/6/06 under the business name of ASSOCIATED DRILLING INC by (signature) [signature]

INSTRUCTIONS: Use typewriter or ball point pen. *PLEASE PRESS FIRMLY* and *PRINT* clearly. Please fill in blanks, underline or circle the correct answers. Send top three copies to Kansas Department of Health and Environment, Bureau of Water, Geology Section, 1000 SW Jackson St., Suite 420, Topeka, Kansas 66612-1367. Telephone 785-296-5522. Send one to WATER WELL OWNER and retain one for your records. Fee of $5.00 for each constructed well.