

0W-8

WATER WELL PLUGGING RECORD Form WWC-5P KSA 82a-1212 ID NO.

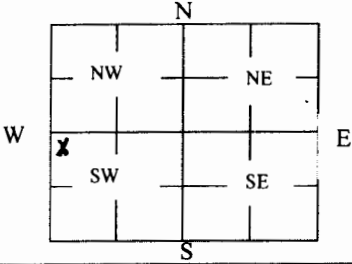
1 LOCATION OF WATER WELL: County: Johnson	Fraction ¼ NW ¼ NW ¼ SW ¼	Section Number 8	Township Number T 13 S	Range Number 25 ☒ E ☐ W
---	------------------------------	---------------------	---------------------------	---

Street/Rural Address of Well Location; if unknown, distance & direction from nearest town or intersection: If at owner's address, check here ☐ BP Amoco 8654

 10701 Metcalf Ave, Overland Park, KS

Global Positioning Systems (GPS) information:
 Latitude: 38.9341 (in decimal degrees)
 Longitude: 94.6665 (in decimal degrees)
 Elevation: _____
 Datum: ☐ WGS84, ☒ NAD83, ☐ NAD27
 Collection Method: ☒ GPS unit (Make/Model: Garmin 60)
☐ Digital Map/Photo, ☐ Topographic Map, ☐ Land Survey
 Est. Accuracy: ☐ < 3 m, ☒ 3-5 m, ☐ 5-15 m, ☐ > 15 m

2 WATER WELL OWNER: Atlantic Richfield Company
 RR#, St. Address, Box #: 501 Westlake Park Blvd
 City, State ZIP Code: Houston, TX 77079

3 MARK WELL'S LOCATION WITH AN "X" IN SECTION BOX:


4 DEPTH OF WELL 12.22 ft.
WELL'S STATIC WATER LEVEL 5.25 ft.
WELL WAS USED AS:

☐ Domestic	☐ Public Water Supply	☐ Dewatering
☐ Irrigation	☐ Oil Field Water Supply	☒ Monitoring
☐ Feedlot	☐ Domestic (Lawn & Garden)	☐ Injection Well
☐ Industrial	☐ Air Conditioning	☐ Other _____

Was a chemical/bacteriological sample submitted to Department? Yes ☐ No ☒

5 TYPE OF BLANK CASING USED:

☒ Steel	☐ RMP (SR)	☐ Wrought	☐ Fiberglass	☐ Other (Specify below) _____
☒ PVC	☐ ABS	☐ Asbestos-Cement	☐ Concrete Tile	

Blank casing diameter 2 in. Was casing pulled? Yes ☒ No ☐ If yes, how much _____
 Casing height above or below land surface Flush in.

6 GROUT PLUG MATERIAL: ☐ Neat cement ☐ Cement grout ☒ Bentonite ☐ Other _____
 Grout Plug Intervals: From 12.22 ft. to 2 ft., From _____ ft. to _____ ft., From _____ to _____ ft.
 What is the nearest source of possible contamination:

☐ Septic tank	☐ Seepage pit	☒ Fuel Storage	☐ Other (specify below) _____
☐ Sewer lines	☐ Pit privy	☐ Fertilizer storage	
☐ Watertight sewer lines	☐ Sewage lagoon	☐ Insecticide storage	
☐ Lateral lines	☐ Feedyard	☐ Abandoned water well	Direction from well? _____
☐ Cess pool	☐ Livestock pens	☐ Oil well/Gas well	How many feet? _____

FROM	TO	PLUGGING MATERIALS	FROM	TO	PLUGGING MATERIALS
12.22	2	Bentonite			
2	0	Concrete			

7 CONTRACTOR'S OR LANDOWNER'S CERTIFICATION: This water well was plugged under my jurisdiction and was completed on (mo/day/year) 3/30/11 and this record is true to the best of my knowledge and belief. Kansas Water Well Contractor's License No. 710. This Water Well Record was completed on (mo/day/year) 4/8/2011 under the business name of Below Ground Surface, Inc. by (signature) [Signature]

INSTRUCTIONS: Use typewriter or ballpoint pen. Please press firmly and print clearly. Please fill in blanks, underline or circle the correct answers. Send top three copies to Kansas Department of Health and Environment, Bureau of Water, Geology Section, 1000 SW Jackson St., Ste. 420, Topeka, Kansas 66612-1367. Telephone: 785/296-5524. Send one to Water Well Owner and retain one for your records. Visit us at <http://www.kdheks.gov/waterwell/index.html>.

Check one: ☐ White Copy ☐ Blue Copy ☐ Pink Copy