


MW-11

WATER WELL PLUGGING RECORD Form WWC-5P KSA 82a-1212 ID NO.

1 LOCATION OF WATER WELL: County: Johnson Fraction SE 1/4 SE 1/4 NE 1/4 NE 1/4 Section Number 5 Township Number T 13 S Range Number 25 [X] E [ ] W

Street/Rural Address of Well Location; if unknown, distance & direction from nearest town or intersection: If at owner's address, check here [ ] 9640 Nall Ave.; Overland Park, KS Global Positioning Systems (GPS) information: Latitude: 38.9540 (in decimal degrees) Longitude: 94.6491 (in decimal degrees) Elevation: Datum: [ ] WGS84, [X] NAD83, [ ] NAD27 Collection Method: [X] GPS unit (Make/Model: Garmin 60) [ ] Digital Map/Photo, [ ] Topographic Map, [ ] Land Survey Est. Accuracy: [ ] < 3 m, [X] 3-5 m, [ ] 5-15 m, [ ] > 15 m

2 WATER WELL OWNER: Shell Oil Products RR#, St. Address, Box #: 308 Wilcox #101 City, State ZIP Code: Castle Rock, CO 80104

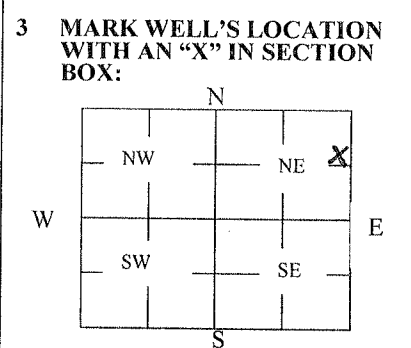

4 DEPTH OF WELL 14 ft. WELL'S STATIC WATER LEVEL 4.17 ft. WELL WAS USED AS: [ ] Domestic [ ] Irrigation [ ] Feedlot [ ] Industrial [ ] Public Water Supply [ ] Oil Field Water Supply [ ] Domestic (Lawn & Garden) [ ] Air Conditioning [ ] Dewatering [X] Monitoring [ ] Injection Well [ ] Other Was a chemical/bacteriological sample submitted to Department? Yes [ ] No [X]

5 TYPE OF BLANK CASING USED: [X] Steel [ ] RMP (SR) [ ] Wrought [ ] Fiberglass [ ] Other (Specify below) [X] PVC [ ] ABS [ ] Asbestos-Cement [ ] Concrete Tile Blank casing diameter 2 in. Was casing pulled? Yes [X] No [ ] If yes, how much All Casing height above or below land surface -6 in.

6 GROUT PLUG MATERIAL: [ ] Neat cement [ ] Cement grout [X] Bentonite [ ] Other Grout Plug Intervals: From 3 ft. to 14 ft., From — ft. to — ft., From — to — ft. What is the nearest source of possible contamination: [ ] Septic tank [ ] Sewer lines [ ] Watertight sewer lines [ ] Lateral lines [ ] Cess pool [ ] Seepage pit [ ] Pit privy [ ] Sewage lagoon [ ] Feedyard [ ] Livestock pens [X] Fuel Storage [ ] Fertilizer storage [ ] Insecticide storage [ ] Abandoned water well [ ] Oil well/Gas well [ ] Other (specify below) Direction from well? How many feet?

Table with columns: FROM, TO, PLUGGING MATERIALS. Row 1: 0, 3, Top Soil. Row 2: 3, 14, Bentonite.

7 CONTRACTOR'S OR LANDOWNER'S CERTIFICATION: This water well was plugged under my jurisdiction and was completed on (mo/day/year) 04/03/12 and this record is true to the best of my knowledge and belief. Kansas Water Well Contractor's License No. 710. This Water Well Record was completed on (mo/day/year) 04/16/12 under the business name of Below Ground Surface, Inc. by (signature)

INSTRUCTIONS: Use typewriter or ballpoint pen. Please press firmly and print clearly. Please fill in blanks, underline or circle the correct answers. Send top three copies to Kansas Department of Health and Environment, Bureau of Water, Geology Section, 1000 SW Jackson St., Ste. 420, Topeka, Kansas 66612-1367. Telephone: 785/296-5524. Send one to Water Well Owner and retain one for your records. Visit us at http://www.kdheks.gov/waterwell/index.html.

Check one: [ ] White Copy [ ] Blue Copy [ ] Pink Copy