

WATER WELL RECORD Form WWC-5


Division of Water Resources App. No.

Well ID

Original Record Correction Change in Well Use

1 LOCATION OF WATER WELL: County: Johnson Fraction SW 1/4 SW 1/4 NE 1/4 SW 1/4 Section Number 16 Township Number T 13 S Range Number R 25 E W

2 WELL OWNER: Last Name: First: Street or Rural Address where well is located: UMB Bank, 928 Grand Blvd, Kansas City, MO 64106, Town Center Drive and W. 117th Street Leawood, KS

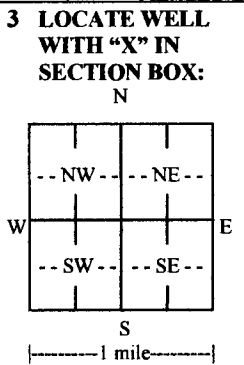

4 DEPTH OF COMPLETED WELL: 350 ft. Depth(s) Groundwater Encountered: 1) ... 2) ... 3) ... 4) Dry Well. WELL'S STATIC WATER LEVEL: 0 ft. below land surface, measured on (mo-day-yr).

5 Latitude: 38.917186 (decimal degrees) Longitude: -94.643449 (decimal degrees) Horizontal Datum: WGS 84 NAD 83 NAD 27 Source for Latitude/Longitude: GPS (unit make/model: WAAS enabled? Yes No) Land Survey Topographic Map Online Mapper

6 Elevation: ... ft. Ground Level TOC Source: Land Survey GPS Topographic Map Other

7 WELL WATER TO BE USED AS: 1. Domestic: Household Lawn & Garden Livestock 2. Irrigation 3. Feedlot 4. Industrial 5. Public Water Supply: well ID 6. Dewatering: how many wells? 7. Aquifer Recharge: well ID 8. Monitoring: well ID 9. Environmental Remediation: well ID Air Sparge Soil Vapor Extraction Recovery Injection 10. Oil Field Water Supply: lease 11. Test Hole: well ID Cased Uncased Geotechnical 12. Geothermal: how many bores? 1 TEST a) Closed Loop Horizontal Vertical b) Open Loop Surface Discharge Inj. of Water 13. Other (specify):

Was a chemical/bacteriological sample submitted to KDHE? Yes No If yes, date sample was submitted: Water well disinfected? Yes No fusion

8 TYPE OF CASING USED: Steel PVC Other HD Poly CASING JOINTS: Glued Clamped Welded Threaded Casing diameter: 1 1/4 in. to 350 ft., Diameter 36 in. to ... ft., Diameter ... in. to ... ft., Diameter ... in. to ... ft. Casing height above land surface 36 in. Weight SDR11 lbs./ft. Wall thickness or gauge No. 160 PSI TYPE OF SCREEN OR PERFORATION MATERIAL: None Steel Stainless Steel Fiberglass PVC Brass Galvanized Steel Concrete tile None used (open hole) SCREEN OR PERFORATION OPENINGS ARE: None Continuous Slot Mill Slot Gauze Wrapped Torch Cut Drilled Holes Other (Specify) Louvered Shutter Key Punched Wire Wrapped Saw Cut None (Open Hole) SCREEN-PERFORATED INTERVALS: From ... ft. to ... ft., From ... ft. to ... ft., From ... ft. to ... ft. GRAVEL PACK INTERVALS: From ... ft. to ... ft., From ... ft. to ... ft., From ... ft. to ... ft.

9 GROUT MATERIAL: Neat cement Cement grout Bentonite Other Grout Intervals: From 350 ft. to 3 ft., From ... ft. to ... ft., From ... ft. to ... ft. Nearest source of possible contamination: Septic Tank Lateral Lines Pit Privy Livestock Pens Insecticide Storage Sewer Lines Cess Pool Sewage Lagoon Fuel Storage Abandoned Water Well Watertight Sewer Lines Seepage Pit Feedyard Fertilizer Storage Oil Well/Gas Well Other (Specify): Direction from well? Distance from well? ft.

Table with columns: FROM, TO, LITHOLOGIC LOG, FROM, TO, LITHO. LOG (cont.) or PLUGGING INTERVALS. Rows include soil/clay wet, slough, lime, shale, sand, and Thermal Enhanced Grout.

11 CONTRACTOR'S OR LANDOWNER'S CERTIFICATION: This water well was constructed, reconstructed, or plugged under my jurisdiction and was completed on (mo-day-year) 04/13/2016 and this record is true to the best of my knowledge and belief. Kansas Water Well Contractor's License No. 561 This Water Well Record was completed on (mo-day-year) 04/13/2016 under the business name of Evans Energy Development, Inc. Signature