

**WATER WELL PLUGGING RECORD Form WWC-5P**

KSA 82a-1212

ID NO.

MW-2

|   |                                 |                     |                           |   |
|---|---------------------------------|---------------------|---------------------------|---|
| <b>1 LOCATION OF WATER WELL:</b><br>County: Johnson | Fraction<br>SW ¼ SW ¼ SW ¼ SW ¼ | Section Number<br>7 | Township Number<br>T 13 S | Range Number<br>25 <input checked="" type="checkbox"/> E <input type="checkbox"/> W |
|---|---------------------------------|---------------------|---------------------------|---|

Street/Rural Address of Well Location; if unknown, distance & direction from nearest town or intersection: If at owner's address, check here  8696 College Blvd.

Overland Park, Kansas

**Global Positioning Systems (GPS) information:**

Latitude: 38.92776 (in decimal degrees)

Longitude: -94.68578 (in decimal degrees)

Elevation: 1027.84 feet amsl

Datum:  WGS84,  NAD83,  NAD27

Collection Method:


GPS unit (Make/Model: \_\_\_\_\_)

Digital Map/Photo,  Topographic Map,  Land Survey

Est. Accuracy:  < 3 m,  3-5 m,  5-15 m,  > 15 m

**2 WATER WELL OWNER:** BP Products North America  
RR#, St. Address, Box #: 1701 Summit Avenue  
City, State ZIP Code: Plano, TX 75074

**3 MARK WELL'S LOCATION WITH AN "X" IN SECTION BOX:**

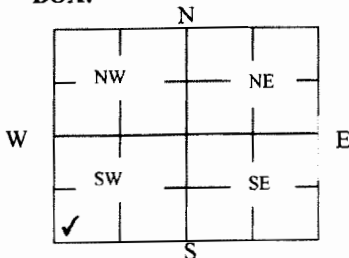

**4 DEPTH OF WELL** 13.89 ft.

WELL'S STATIC WATER LEVEL 6.79 ft

WELL WAS USED AS:

- Domestic
- Irrigation
- Feedlot
- Industrial

- Public Water Supply
- Oil Field Water Supply
- Domestic (Lawn & Garden)
- Air Conditioning

- Dewatering
- Monitoring
- Injection Well
- Other \_\_\_\_\_

Was a chemical/bacteriological sample submitted to Department? Yes  No

**5 TYPE OF BLANK CASING USED:**

- Steel
- PVC
- RMP (SR)
- ABS
- Wrought
- Asbestos-Cement
- Fiberglass
- Concrete Tile
- Other (Specify below) \_\_\_\_\_

Blank casing diameter 2 in. Was casing pulled? Yes  No  If yes, how much 13.89 feet  
Casing height above or below land surface \_\_\_\_\_ in.

**6 GROUT PLUG MATERIAL:**  Neat cement  Cement grout  Bentonite  Other \_\_\_\_\_

Grout Plug Intervals: From 3 ft. to 13.89 ft., From \_\_\_\_\_ ft. to \_\_\_\_\_ ft., From \_\_\_\_\_ to \_\_\_\_\_ ft.

What is the nearest source of possible contamination:

- Septic tank
- Sewer lines
- Watertight sewer lines
- Lateral lines
- Cess pool
- Seepage pit
- Pit privy
- Sewage lagoon
- Feedyard
- Livestock pens
- Fuel Storage
- Fertilizer storage
- Insecticide storage
- Abandoned water well
- Oil well/Gas well
- Other (specify below) \_\_\_\_\_

Direction from well? \_\_\_\_\_  
How many feet? \_\_\_\_\_

| FROM | TO    | PLUGGING MATERIALS  | FROM | TO | PLUGGING MATERIALS |
|------|-------|---------------------|------|----|--------------------|
| 0    | 1     | Top soil/grass seed |      |    |                    |
| 1    | 3     | Soil/gravel         |      |    |                    |
| 3    | 13.89 | Bentonite           |      |    |                    |
|      |       |                     |      |    |                    |
|      |       |                     |      |    |                    |
|      |       |                     |      |    |                    |

**7 CONTRACTOR'S OR LANDOWNER'S CERTIFICATION:** This water well was plugged under my jurisdiction and was completed on (mo/day/year) 12/23/2016 and this record is true to the best of my knowledge and belief. Kansas Water Well Contractor's License No. 708. This Water Well Record was completed on (mo/day/year) 01/03/2017 under the business name of SCS Engineers by signature *[Signature]*

**INSTRUCTIONS:** Use typewriter or ballpoint pen. Please press firmly and print clearly. Please fill in blanks, underline or circle the correct answers. Send top three copies to Kansas Department of Health and Environment, Bureau of Water, Geology Section, 1000 SW Jackson St., Ste. 420, Topeka, Kansas 66612-1367. Telephone: 785/296-5524. Send one to Water Well Owner and retain one for your records. Visit us at <http://www.kdheks.gov/waterwell/index.html>.

Check one:  White Copy  Blue Copy  Pink Copy