
WATER '			Form V				ion of Water			LMW-4	
	Record			e in Well Usc			rces App. No		Well ID		
1 LOCAT		ATER WEI	L:	Fraction			ion Number	Township Numb		nge Number	
County:	Johnson			NM N NM N NN			8	T 13 S		5 E C W	
2 WELL C				First:				here well is located			
Business: Star Fuel Centers Inc. direction from nearest town or intersection): If at owner's address, check h										check here:	
Address: 11161 Overbrook Road, Suite 150 Address: 10701 Metcalf Avenue, Overland Park, KS											
1/0											
2 Y O CLIMP WERT Y											
4 DEPTH OF COMPLETED WELL:										(decimal degrees)	
	SECTION BOY. Depth(s) Groundwater Encountered: 1)14.23.							Longitude: 94.666925 (decimal degrees)			
	N 2)							ital Datum: DWGS 8		83 🖺 NAD 27	
	WELL'S STATIC WATER LEVEL:							Source for Latitude/Longitude: GPS (unit make/model:)			
1 ' 1	below land surface, measured on (mo-day-yr)						☐ GP				
NW	Pump test data: Well water was							(WAAS enabled?		NO)	
	The second secon							☐ Land Survey ☐ Topographic Map Online Mapper: Google Maps			
W	Well water was ft.						On the triapper.				
sw	SW SE after hours pumping gpi						(ADD)				
	Estimated Yield:gpm				٠,	6 Elevation: 321t. Ground Level					
S	S Bore Hole Diameter:8.25 in. to					and	and Source: Land Survey GPS Topographic Map				
1 m	mile Other Google Maps										
7 WELL WATER TO BE USED AS:											
1. Domestic:								10. Oil Field Water Supply: lease			
	☐ Household 6. ☐ Dewatering: how many wells?						11. Test Hole; well ID				
	☐ Lawn & Garden ☐ Livestock 7. ☐ Aquifer Recharge: well ID						☐ Cased ☐ Uncased ☐ Geotechnical				
-								12. Geothermal: how many bores?			
	☐ Irrigation ☐ Feedlot ☐ Air Sparge ☐ Soil Vapor Extraction							a) Closed Loop			
						action	• • • • •				
4. Industrial Recovery Injection 13. Other (specify):											
Was a chemical/bacteriological sample submitted to KDHE? Tyes No If yes, date sample was submitted:											
Water well disinfected? Tyes No											
8 TYPE OF CASING USED: Steel PVC Other CASING JOINTS: Glued Clamped Welded Threaded											
Casing diameter											
Casing height above land surface											
TYPE OF SCREEN OR PERFORATION MATERIAL:											
☐ Steel ☐ Stainless Steel ☐ Fiberglass ■ PVC ☐ Other (Specify)											
☐ Brass ☐ Galvanized Steel ☐ Concrete tile ☐ None used (open hole)											
SCREEN OR PERFORATION OPENINGS ARE:											
Continuous Slot Mill Slot Gauze Wrapped Torch Cut Drilled Holes Other (Specify)											
□ Louvered Shutter □ Key Punched □ Wire Wrapped □ Saw Cut □ None (Open Hole)											
SCREEN-PERFORATED INTERVALS: From .4.87 ft. to .14.87 ft., From ft. to ft. to ft. o											
GRAVEL PACK INTERVALS: From											
9 GROUT MATERIAL: Neat cement Cement grout Bentonite Other											
Grout Intervals: From											
			tion: Lateral Lin	es	v	П	Livestock Per	ne 🗀 Insec	ticide Stora	ae.	
☐ Septic			Cess Pool				Fuel Storage		doned Wate		
□ Sewer Lines □ Cess Pool □ Sewage Lagoon ■ Fuel Storage □ Abandoned Water Well □ Watertight Sewer Lines □ Seepage Pit □ Feedyard □ Fertilizer Storage □ Oil Well/Gas Well											
Other (Specify)											
Direction from well? East Distance from well? .25											
10 FROM	TO		LITHOLO	GIC LOG		FROM	TO	LITHO, LOG (cont.)	or PLUGG	NG INTERVALS	
0	10	Silt with cla	ΙV								
10	14.87	Weathered									
				<u> </u>							

					$\neg \uparrow$	Notes:					
11 CONTRACTOR'S OR LANDOWNER'S CERTIFICATION: This water well was 22 constructed, \square reconstructed, or \square plugged											
under my jurisdiction and was completed on (mo-day-year) .12/12/19 and this record is true to the best of my knowledge and belief. Kansas Water Well Contractor's License No This Water Well Record was completed on (mo-day-year)											
Kansas Wa	ter Well Co	ontractor's L	icense No.	73 This	Wate	r Well Re	cord was cor	npleted on (mo-day	-year)/.	14-7.0	
under the b	usiness nar	ne ofEns.	manufed.	Mark Lover		S	gnature	ghe of		. 4	
Mail 1 white copy along with a fee of \$5.00 for each constructed well to: Kansas Department of Health and Environment, Bureau of Water, GWTS Section,											
1000 SW Jackson St., Suite 420, Topeka, Kansas 66612-1367. Mail one to Water Well Owner and retain one for your records. Telephone 785-296-5524.											
Visit us at http://www.kdheks.gov/waterwell/index.html KSA 82a-1212 Revised 7/10/2015											

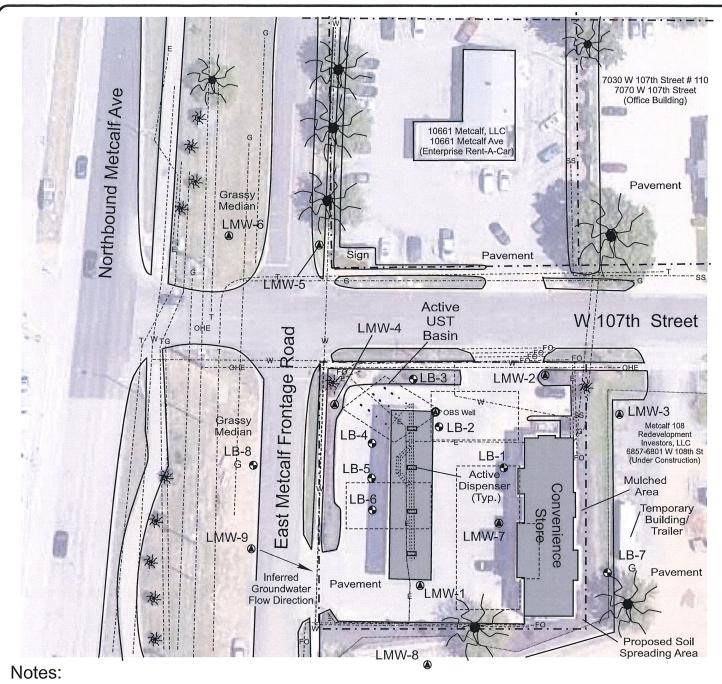

- Proposed Soil Boring Location (borings denoted with (G) for hydrologic samples)
- Tank Basin Observation Well

Proposed Monitoring Well

Product Line Location

UST Location

·- Property Boundary

米 Tree (approx.) Fence

- Buried Storm Sewer Line (3' 5' depth, approx.) StS
- Buried Sanitary Sewer Line (3' 5' depth, approx.) SS
- Т Buried Tele/Fiber Optic Line (3'-5' depth, approx.)
- Buried Gas Line (3' 5' depth, approx.) G
- Buried Water Line (4' depth, approx.) W
- Buried Electric Line (2' 3' depth, approx.) E
- Buried Traffic Line (2' 3' depth, approx.) Tr
- FΩ Buried Fiber Optic Line (2' - 3' depth, approx.)
- OHE Overhead Electric, Cable, & Telephone Line (15' ave height, approx.)

All drilling proposed for site owned by 7-Eleven, Inc..

