WATER WELL PLUGGING RECORD Form WWC-5P KSA 82a-1212 ID NO. LMW-7

1 LOCATION OF WATER WELL: County: Johnson | Fraction: NW ¼ NW¼ NW ¼ SW ¼ | Section Number: 8 | Township Number: T 13 S | Range Number: R 25 ☑ E ☐ W

Street/Rural Address of Well Location; if unknown, distance & direction from nearest town or intersection: If at owner's address, check here ☐ 10701 Metcalf Avenue, Overland Park, KS

Global Positioning Systems (GPS) information:
Latitude: 38.933908 (in decimal degrees)
Longitude: 94.666583 (in decimal degrees)
Elevation: 922
Horizontal Datum: ☐ WGS84, ☐ NAD83, ☐ NAD27
Collection Method:
☐ GPS unit (Make/Model: _____)
☑ Digital Map/Photo, ☐ Topographic Map, ☐ Land Survey
Est. Accuracy: ☐ <3 m, ☑ 3-5 m, ☐ 5-15 m, ☐ >15 m

2 WATER WELL OWNER: Star Fuel Centers, Inc.
RR#, St. Address, Box #: 7415 W. 130th Street, Suite 100
City, State ZIP Code: Overland Park, KS 66213

3 MARK WELL'S LOCATION WITH AN "X" IN SECTION BOX:

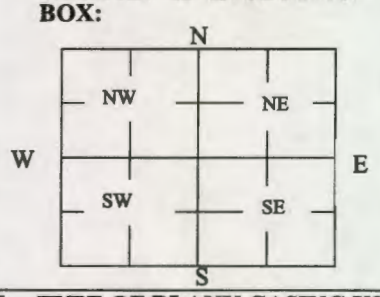

4 DEPTH OF WELL 13.87 ft.
WELL'S STATIC WATER LEVEL 7.95 ft
WELL WAS USED AS:

☐ Domestic	☐ Public Water Supply	☑ Dewatering
☐ Irrigation	☐ Oil Field Water Supply	☑ Monitoring
☐ Feedlot	☐ Domestic (Lawn & Garden)	☐ Injection Well
☐ Industrial	☐ Air Conditioning	☐ Other _____

Was a chemical/bacteriological sample submitted to Department? Yes ☐ No ☑

5 TYPE OF BLANK CASING USED:

☐ Steel	☐ RMP (SR)	☐ Wrought	☐ Fiberglass	☐ Other (Specify below)
☑ PVC	☐ ABS	☐ Asbestos-Cement	☐ Concrete Tile	_____

Blank casing diameter 2.0 in. Was casing pulled? Yes ☑ No ☐ If yes, how much 3.0 ft.
Casing height above or below land surface -0.46 in.

6 GROUT PLUG MATERIAL: ☐ Neat cement ☐ Cement grout ☑ Bentonite ☐ Other _____

Grout Plug Intervals: From 13.85 ft. to 0.5 ft., From _____ ft. to _____ ft., From _____ ft. to _____ ft.

What is the nearest source of possible contamination:

☐ Septic tank	☐ Seepage pit	☑ Fuel storage	☐ Other (specify below)
☐ Sewer lines	☐ Pit privy	☐ Fertilizer storage	_____
☐ Watertight sewer lines	☐ Sewage lagoon	☐ Insecticide storage	
☐ Lateral lines	☐ Feedyard	☐ Abandoned water well	Direction from well? SE
☐ Cess pool	☐ Livestock pens	☐ Oil well/Gas well	How many feet? 96

FROM	TO	PLUGGING MATERIALS	FROM	TO	PLUGGING MATERIALS
13.85	0.5	Hydrated Bentonite			
0.5	Grade	Concrete			

7 CONTRACTOR'S OR LANDOWNER'S CERTIFICATION: This water well was plugged under my jurisdiction and was completed on (mo/day/year) 8/26/22 and this record is true to the best of my knowledge and belief. Kansas Water Well Contractor's License No. _____. This Water Well Record was completed on (mo/day/year) _____ under the business name of Dakota Technologies Company, LLC by (signature) _____

Send one white copy to Kansas Department of Health & Environment, Geology Section, 1000 SW Jackson Street, Ste. 420, Topeka, KS 66612-1367. Send one copy to WATER WELL OWNER and retain one for your records.
Visit us at http://www.kdheks.gov/waterwell/index.html Telephone 785-296-5524.

KSA82a-1212 **Revised 1/20/2015**