


1 LOCATION OF WATER WELL: Fraction NE 1/4 NE 1/4 SE 1/4 Section Number 29 Township Number T 13 S Range Number R 3 E/W
 County: Dickinson Distance and direction from nearest town or city street address of well if located within city?

1/2 mile South of Enterprise, Ks on Hwy 43

2 WATER WELL OWNER: Charles Phillips
 RR#, St. Address, Box #: 801 S. Lincoln Board of Agriculture, Division of Water Resources
 City, State, ZIP Code: Enterprise, Kansas 67441 Application Number:

3 LOCATE WELL'S LOCATION WITH AN "X" IN SECTION BOX:

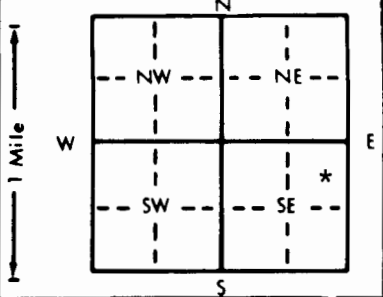

4 DEPTH OF COMPLETED WELL... 95 ft. ELEVATION:
 Depth(s) Groundwater Encountered 1... 4.1 ft. 2... ft. 3... ft.
 WELL'S STATIC WATER LEVEL... 30 ft. below land surface measured on mo/day/yr 12 / .4 / .95
 Pump test data: Well water was ... ft. after ... hours pumping ... gpm
 Est. Yield ... 30+ gpm: Well water was ... ft. after ... hours pumping ... gpm
 Bore Hole Diameter... 9 in. to 9.5 ft., and ... in. to ... ft.
 WELL WATER TO BE USED AS:
 1 Domestic 3 Feedlot 6 Oil field water supply 8 Air conditioning 11 Injection well
 2 Irrigation 4 Industrial 7 Lawn and garden only 9 Dewatering 12 Other (Specify below)
 Was a chemical/bacteriological sample submitted to Department? Yes... No... *...; If yes, mo/day/yr sample was submitted
 Water Well Disinfected? Yes * No

5 TYPE OF BLANK CASING USED:
 1 Steel 3 RMP (SR) 5 Wrought iron 8 Concrete tile CASING JOINTS: Glued * Clamped
 2 PVC 4 ABS 6 Asbestos-Cement 9 Other (specify below) Welded
 7 Fiberglass Threaded
 Blank casing diameter... 5 in. to 9.5 ft., Dia... in. to ... ft., Dia... in. to ... ft.
 Casing height above land surface... 16 in., weight... 160 lbs./ft. Wall thickness or gauge No. ... 2.14

TYPE OF SCREEN OR PERFORATION MATERIAL:
 1 Steel 3 Stainless steel 5 Fiberglass 7 PVC 10 Asbestos-cement
 2 Brass 4 Galvanized steel 6 Concrete tile 8 RMP (SR) 11 Other (specify)
 9 ABS 12 None used (open hole)
 SCREEN OR PERFORATION OPENINGS ARE:
 1 Continuous slot 3 Mill slot 5 Gauzed wrapped 8 Saw cut 11 None (open hole)
 2 Louvered shutter 4 Key punched 6 Wire wrapped 9 Drilled holes
 7 Torch cut 10 Other (specify)

SCREEN-PERFORATED INTERVALS: From... 33 ft. to 61 ft., From... ft. to... ft.
 GRAVEL PACK INTERVALS: From... 24 ft. to 95 ft., From... ft. to... ft.

6 GROUT MATERIAL: 1 Neat cement 2 Cement grout 3 Bentonite 4 Other
 Grout Intervals: From... 3 ft. to 24 ft., From... ft. to... ft., From... ft. to... ft.
 What is the nearest source of possible contamination:
 1 Septic tank 4 Lateral lines 7 Pit privy 10 Livestock pens 14 Abandoned water well
 2 Sewer lines 5 Cess pool 8 Sewage lagoon 11 Fuel storage 15 Oil well/Gas well
 3 Watertight sewer lines 6 Seepage pit 9 Feedyard 12 Fertilizer storage 16 Other (specify below)
 13 Insecticide storage
 Direction from well? NORTHWEST How many feet? 105

FROM	TO	LITHOLOGIC LOG	FROM	TO	PLUGGING INTERVALS
0	1	DARK TOP SOIL			
1	4	LITE COLOR LIMESTONE			
4	9	LITE COLOR CLAY & SHALE			
9	20	RED SHALE			
20	23	LITE GRAY SHALE			
23	30-6	LITE COLOR SHALE			
30-6	43	LITE COLOR LIMESTONE			
43	45	TAN CLAY			
45	45-6	LIMESTONE			
45-6	58	LITE COLOR CLAY & SHALE			
58	61	HARD LIMESTONR & FLINT			
61	70	SOFT TAN CLAY			
70	72	LITE COLOR LIMESTONE			
72	76	LITE COLOR SHALE & CLAY			
76	79	GRAY CLAY & SHALE			

7 CONTRACTOR'S OR LANDOWNER'S CERTIFICATION: This water well was (1) constructed, (2) reconstructed, or (3) plugged under my jurisdiction and was completed on (mo/day/year) 12 / .4 / .95 and this record is true to the best of my knowledge and belief. Kansas Water Well Contractor's License No. 397 This Water Well Record was completed on (mo/day/yr) 12 / .11 / .95 under the business name of CENTRAL KANSAS DRILLING by (signature) Harold D. Martin

00000