


1) LOCATION OF WATER WELL: Fraction SE 1/4 SE 1/4 NE 1/4 Section Number 30 Township Number T 13 S Range Number R 3 E

Distance and direction from nearest town or city street address of well if located within city?  
1/2 mile West of Enterprise, ks & 1/2 mile South & 3/8 mile West

2) WATER WELL OWNER: Lee Swanson  
 RR#, St. Address, Box # : 1941 Lark Rd. Board of Agriculture, Division of Water Resources  
 City, State, ZIP Code : Enterprise, Kansas 67441 Application Number:

3) LOCATE WELL'S LOCATION WITH AN "X" IN SECTION BOX:

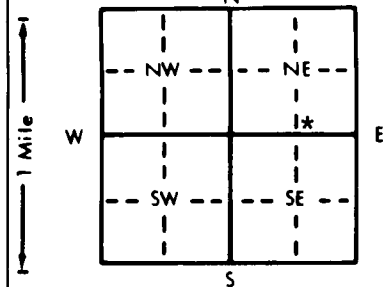

4) DEPTH OF COMPLETED WELL: 136 ft. ELEVATION:  
 Depth(s) Groundwater Encountered 1. 106 ft. 2.          ft. 3.          ft.  
 WELL'S STATIC WATER LEVEL 95 ft. below land surface measured on mo/day/yr 3 / 28 / 96  
 Pump test data: Well water was          ft. after          hours pumping          gpm  
 Est. Yield 15+ gpm: Well water was          ft. after          hours pumping          gpm  
 Bore Hole Diameter 9 in. to 136 ft., and          in. to          ft.  
 WELL WATER TO BE USED AS: 5 Public water supply 8 Air conditioning 11 Injection well  
 1 Domestic 3 Feedlot 6 Oil field water supply 9 Dewatering 12 Other (Specify below)  
 2 Irrigation 4 Industrial 7 Lawn and garden only 10 Monitoring well Livestock  
 Was a chemical/bacteriological sample submitted to Department? Yes          No \*; If yes, mo/day/yr sample was submitted  
 Water Well Disinfected? Yes \* No

5) TYPE OF BLANK CASING USED: 5 Wrought iron 8 Concrete tile CASING JOINTS: Glued \* Clamped  
 1 Steel 3 RMP (SR) 6 Asbestos-Cement 9 Other (specify below) Welded  
 2 PVC 4 ABS 7 Fiberglass Threaded  
 Blank casing diameter 5 in. to 136 ft., Dia          in. to          ft., Dia          in. to          ft.  
 Casing height above land surface 18 in., weight 200 lbs./ft. Wall thickness or gauge No. 250  
 TYPE OF SCREEN OR PERFORATION MATERIAL: 7 PVC 10 Asbestos-cement  
 1 Steel 3 Stainless steel 5 Fiberglass 8 RMP (SR) 11 Other (specify)  
 2 Brass 4 Galvanized steel 6 Concrete tile 9 ABS 12 None used (open hole)  
 SCREEN OR PERFORATION OPENINGS ARE: 5 Gauzed wrapped 8 Saw cut 11 None (open hole)  
 1 Continuous slot 3 Mill slot 6 Wire wrapped 9 Drilled holes  
 2 Louvered shutter 4 Key punched 7 Torch cut 10 Other (specify)  
 SCREEN-PERFORATED INTERVALS: From 97 ft. to 136 ft., From          ft. to          ft.  
 From          ft. to          ft., From          ft. to          ft.  
 GRAVEL PACK INTERVALS: From 33 ft. to 136 ft., From          ft. to          ft.  
 From          ft. to          ft., From          ft. to          ft.

6) GROUT MATERIAL: 1 Neat cement 2 Cement grout 3 Bentonite 4 Other  
 Grout intervals: From 3 ft. to 33 ft., From          ft. to          ft., From          ft. to          ft.  
 What is the nearest source of possible contamination:  
 1 Septic tank 4 Lateral lines 7 Pit privy 10 Livestock pens 14 Abandoned water well  
 2 Sewer lines 5 Cess pool 8 Sewage lagoon 11 Fuel storage 15 Oil well/Gas well  
 3 Watertight sewer lines 6 Seepage pit 9 Feedyard 12 Fertilizer storage 16 Other (specify below)  
 13 Insecticide storage  
 Direction from well? NORTH How many feet? 2000

FROM	TO	LITHOLOGIC LOG	FROM	TO	PLUGGING INTERVALS
0	2	LIMESTONE LITE COLOR	106	108	LIMESTONE & DARK FLINT ROCK
2	9	LITE COLOR SHALEY CLAY	108	127	GRAY SHALE & CLAY
9	11	RED CLAY	127	136	RED CLAY & SHALE
11	21	LITE COLOR CLAY			
21	22	LITE COLOR LIMESTONE			
22	31	LITE COLOR SHALE & CLAY			
31	42	LITE COLOR LIMESTONE			
42	51	GRAY SHALE & CLAY			
51	53	HARD LIMESTONE DARK COLOR			
53	56	DARK GREEN SHALE			
56	61	LITE GRAY SHALE			
61	74	RED SHALE & CLAY			
74	78	LITE GRAY & TAN SHALE			
78	94	LITE COLOR LIMESTONE			
94	106	LITE COLOR SHALE & CLAY			

7) CONTRACTOR'S OR LANDOWNER'S CERTIFICATION: This water well was (1) constructed, (2) reconstructed, or (3) plugged under my jurisdiction and was completed on (mo/day/year) 3 / 28 / 96 and this record is true to the best of my knowledge and belief. Kansas Water Well Contractor's License No. 397 This Water Well Record was completed on (mo/day/yr) 4 / 12 / 96 under the business name of CENTRAL KANSAS DRILLING by (signature) Harold D. Matton

INSTRUCTIONS: Use typewriter or ball point pen. PLEASE PRESS FIRMLY and PRINT clearly. Please fill in blanks, underline or circle the correct answers. Send top three copies to Kansas Department of Health and Environment, Bureau of Water, Topeka, Kansas 66620-0001. Telephone: 913-296-5545. Send one to WATER WELL OWNER and retain one for your records.