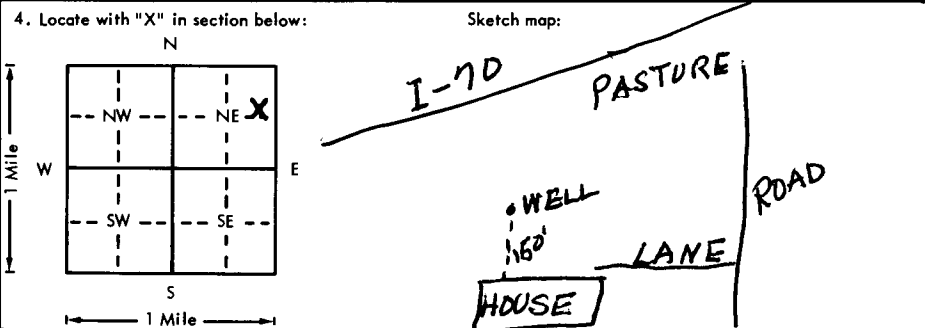
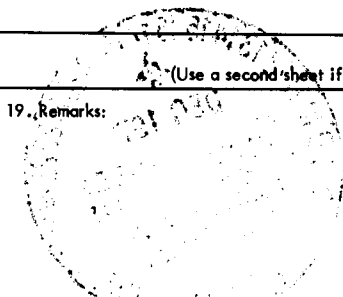


USE TYPEWRITER OR BALL POINT PEN-PRESS FIRMLY, PRINT CLEARLY.

WATER WELL RECORD
KSA 82a-1201-1215

Kansas Department of Health and Environment-Division of Environment (Water well Contractors) Topeka, Kansas 66620

1. Location of well:		County Dickinson	Fraction SE 1/4 NE 1/4 NE 1/4	Section number 7	Township number T 13	Range number S R 3
2. Distance and direction from nearest town or city: Street address of well location if in city: 1 mile west and 3/4 north of Detroit,				3. Owner of well: Ethel Anderson R.R. or street: R.R. # 5 City, state, zip code: Abilene, Kansas 67410		
4. Locate with "X" in section below: Sketch map: 				6. Bore hole dia. <u>8</u> in. Completion date _____ Well depth <u>91</u> ft. <u>4/11/77</u>		
5. Type and color of material				7. <input checked="" type="checkbox"/> Cable tool <input checked="" type="checkbox"/> Rotary <input type="checkbox"/> Driven <input type="checkbox"/> Dug <input type="checkbox"/> Hollow rod <input type="checkbox"/> Jetted <input type="checkbox"/> Bored <input type="checkbox"/> Reverse rotary		
				8. Use: <input checked="" type="checkbox"/> Domestic <input type="checkbox"/> Public supply <input type="checkbox"/> Industry <input type="checkbox"/> Irrigation <input type="checkbox"/> Air conditioning <input type="checkbox"/> Stock <input type="checkbox"/> Lawn <input type="checkbox"/> Oil field water <input type="checkbox"/> Other		
				9. Casing: Material <u>plst</u> Height: Above or below _____ Threaded <input type="checkbox"/> Welded <input checked="" type="checkbox"/> Surface <u>18</u> in. RMP <input checked="" type="checkbox"/> PVC <input type="checkbox"/> Weight _____ lbs./ft. Dia. <u>5</u> in. to <u>91</u> ft. depth; Wall Thickness: inches or _____ Dia. _____ in. to _____ ft. depth; gage No. <u>0.258</u>		
				10. Screen: Manufacturer's name <u>Western Plastics</u> Type <u>RMP</u> Dia. <u>5"</u> Slot/gauze <u>3/32</u> Length <u>25'</u> Set between <u>66</u> ft. and <u>91</u> ft. _____ ft. and _____ ft. Gravel pack? <u>Yes</u> Size range of material <u>1/16 to 3/8</u>		
				11. Static water level: _____ mo./day/yr. <u>69</u> ft. below land surface Date <u>4/11/77</u>		
				12. Pumping level below land surfaces: _____ ft. after _____ hrs. pumping _____ g.p.m. _____ ft. after _____ hrs. pumping _____ g.p.m. Estimated maximum yield _____ 20 _____ g.p.m.		
				13. Water sample submitted: _____ mo./day/yr. Yes <input type="checkbox"/> No <input checked="" type="checkbox"/> Date _____		
				14. Well head completion: <input type="checkbox"/> Pitless adapter <u>18</u> inches above grade		
				15. Well grouted? <u>Yes</u> With: <input checked="" type="checkbox"/> Neat cement <input type="checkbox"/> Bentonite <input type="checkbox"/> Concrete Depth: From <u>0</u> ft. to <u>10</u> ft.		
				16. Nearest source of possible contamination: ft. <u>20</u> Direction <u>South</u> Type <u>Sewer</u> Well disinfected upon completion? <input checked="" type="checkbox"/> Yes <input type="checkbox"/> No		
				17. Pump: <input checked="" type="checkbox"/> Not installed Manufacturer's name _____ Model number _____ HP _____ Volts _____ Length of drop pipe _____ ft. capacity _____ g.p.m. Type: <input type="checkbox"/> Submersible <input type="checkbox"/> Turbine <input type="checkbox"/> Jet <input type="checkbox"/> Reciprocating <input type="checkbox"/> Centrifugal <input type="checkbox"/> Other		
18. Elevation:		19. Remarks: 		20. Water well contractor's certification: This well was drilled under my jurisdiction and this report is true to the best of my knowledge and belief. Rader Drilling Co. 194 Business name _____ License No. _____ Address Carlton, Kansas 67429 Signed <u>Grant P. Rader</u> Date <u>4-22-77</u> Authorized representative		
Topography: <input type="checkbox"/> Hill <input type="checkbox"/> Slope <input checked="" type="checkbox"/> Upland <input type="checkbox"/> Valley						

T 13 R 3 S W 7 SE NE NE 1/4 1/4 1/4

Forward the white, blue and pink copies to the Department of Health and Environment

Form WWC-5