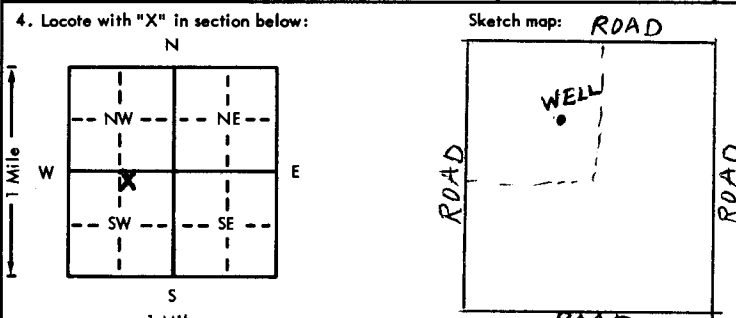


USE TYPEWRITER OR BALL POINT PEN-PRESS FIRMLY, PRINT CLEARLY.

WATER WELL RECORD
KSA 82a-1201-1215

Kansas Department of Health and Environment-Division of Environment
(Water well Contractors)
Topeka, Kansas 66620

| | | | | | | |
|---|--|----------------------------|---|--|--------------------------------------|---------------------------|
| 1. Location of well: | | County Dickinson | Fraction NW 1/4 NE 1/4 SW 1/4 | Section number 8 | Township number T 13 S R 3 | Range number EW |
| 2. Distance and direction from nearest town or city: Street address of well location if in city: Lot 3 Block C Detroit, Kans. | | | | 3. Owner of well: Ivan Cramer R.R. or street: R.R. 5 City, state, zip code: Abilene, Kansas | | |
| 4. Locate with "X" in section below:  | | | | 6. Bore hole dia. 8 in. Completion date _____ Well depth 68 ft. 11/12/75 | | |
| 5. Type and color of material | | | | 7. <input checked="" type="checkbox"/> Cable tool <input checked="" type="checkbox"/> Rotary <input type="checkbox"/> Driven <input type="checkbox"/> Dug <input type="checkbox"/> Hollow rod <input type="checkbox"/> Jetted <input type="checkbox"/> Bored <input type="checkbox"/> Reverse rotary | | |
| | | | | 8. Use: <input checked="" type="checkbox"/> Domestic <input type="checkbox"/> Public supply <input type="checkbox"/> Industry <input type="checkbox"/> Irrigation <input type="checkbox"/> Air conditioning <input type="checkbox"/> Stock <input type="checkbox"/> Lawn <input type="checkbox"/> Oil field water <input type="checkbox"/> Other | | |
| | | | | 9. Casing: Material plst Height: Above or below Threaded <input type="checkbox"/> Welded <input checked="" type="checkbox"/> Surface 18 in. RMP <input type="checkbox"/> PVC <input checked="" type="checkbox"/> Weight _____ lbs./ft. Dia. 5 in. to 68 ft. depth Wall Thickness: inches or Dia. _____ in. to _____ ft. depth gage No. 0.214 | | |
| | | | | 10. Screen: Manufacturer's name Western Plastics Type PVC Dia. 5" Slot/gauze 3/32 Length 40' Set between 28 ft. and 68 ft. _____ ft. and _____ ft. Gravel pack? Yes Size range of material 1/16 to 3/8 | | |
| | | | | 11. Static water level: _____ mo./day/yr. 35 ft. below land surface Date 11/12/75 | | |
| | | | | 12. Pumping level below land surfaces: _____ ft. after _____ hrs. pumping _____ g.p.m. _____ ft. after _____ hrs. pumping _____ g.p.m. Estimated maximum yield 16 g.p.m. | | |
| | | | | 13. Water sample submitted: _____ mo./day/yr. Yes <input checked="" type="checkbox"/> No <input type="checkbox"/> Date _____ | | |
| | | | | 14. Well head completion: <input type="checkbox"/> Pitless adapter 18 Inches above grade | | |
| | | | | 15. Well grouted? Yes With: <input checked="" type="checkbox"/> Neat cement <input type="checkbox"/> Bentonite <input type="checkbox"/> Concrete Depth: From 0 ft. to 10 ft. | | |
| | | | | 16. Nearest source of possible contamination: ft. 160' Direction SW Type SEWER Well disinfected upon completion? <input checked="" type="checkbox"/> Yes <input type="checkbox"/> No | | |
| | | | | 17. Pump: <input checked="" type="checkbox"/> Not installed Manufacturer's name _____ Model number _____ HP _____ Volts _____ Length of drop pipe _____ ft. capacity _____ g.p.m. Type: <input type="checkbox"/> Submersible <input type="checkbox"/> Turbine <input type="checkbox"/> Jet <input type="checkbox"/> Reciprocating <input type="checkbox"/> Centrifugal <input type="checkbox"/> Other | | |
| | | | | 20. Water well contractor's certification: This well was drilled under my jurisdiction and this report is true to the best of my knowledge and belief. Rader Drilling Co. 194 Business name License No. Address Carlton, Kans. 67429 Signed Brent E. Rader Date 12-9-75 Authorized representative | | |
| 18. Elevation: | | 19. Remarks: | | | | |
| Topography: <input type="checkbox"/> Hill <input checked="" type="checkbox"/> Slope <input type="checkbox"/> Upland <input type="checkbox"/> Valley | | | | | | |

Forward the white, blue and pink copies to the Department of Health and Environment

Form WWC-5

L 3
 3
 W
 8
 NW NE SW
 1/4 1/4 1/4