


1 LOCATION OF WATER WELL: Fraction NE 1/4 NE 1/4 SW 1/4 Section Number 8 Township Number T 13 S Range Number R 3 **E**

Distance and direction from nearest town or city street address of well if located within city?
5 miles East of Abilene, Ks on Hwy 40 & 2 blocks North & 2 blocks West

2 WATER WELL OWNER: Dave B lodgett
 RR#, St. Address, Box #: Rt 5 Box 93 Board of Agriculture, Division of Water Resources
 City, State, ZIP Code: Abilene, Kansas 67410 Application Number:

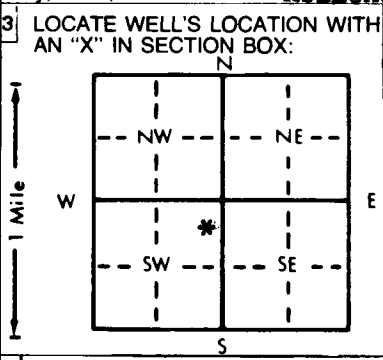

4 DEPTH OF COMPLETED WELL: 87 ft. ELEVATION: _____

Depth(s) Groundwater Encountered 1. 76 ft. 2. _____ ft. 3. _____ ft.

WELL'S STATIC WATER LEVEL 53 ft. below land surface measured on mo/day/yr 2 / 1 / 90

Pump test data: Well water was _____ ft. after _____ hours pumping _____ gpm

Est. Yield 15+ gpm: Well water was _____ ft. after _____ hours pumping _____ gpm

Bore Hole Diameter 9 in. to 87 ft., and _____ in. to _____ ft.

WELL WATER TO BE USED AS: 5 Public water supply 8 Air conditioning 11 Injection well
 1 Domestic 3 Feedlot 6 Oil field water supply 9 Dewatering 12 Other (Specify below)
 2 Irrigation 4 Industrial 7 Lawn and garden only 10 Monitoring well

Was a chemical/bacteriological sample submitted to Department? Yes _____ No *; If yes, mo/day/yr sample was submitted _____

Water Well Disinfected? Yes * No

5 TYPE OF BLANK CASING USED: 5 Wrought iron 8 Concrete tile CASING JOINTS: Glued * Clamped _____
 1 Steel 3 RMP (SR) 6 Asbestos-Cement 9 Other (specify below) Welded _____
 2 PVC 4 ABS 7 Fiberglass Threaded _____

Blank casing diameter 5 in. to 87 ft., Dia _____ in. to _____ ft., Dia _____ in. to _____ ft.

Casing height above land surface 14 in., weight 200 lbs./ft. Wall thickness or gauge No. _____

TYPE OF SCREEN OR PERFORATION MATERIAL: 7 PVC 10 Asbestos-cement
 1 Steel 3 Stainless steel 5 Fiberglass 8 RMP (SR) 11 Other (specify) _____
 2 Brass 4 Galvanized steel 6 Concrete tile 9 ABS 12 None used (open hole)

SCREEN OR PERFORATION OPENINGS ARE: 5 Gauzed wrapped 8 Saw cut 11 None (open hole)
 1 Continuous slot 3 Mill slot 6 Wire wrapped 9 Drilled holes
 2 Louvered shutter 4 Key punched 7 Torch cut 10 Other (specify) _____

SCREEN-PERFORATED INTERVALS: From 54 ft. to 87 ft., From _____ ft. to _____ ft.
 From _____ ft. to _____ ft., From _____ ft. to _____ ft.

GRAVEL PACK INTERVALS: From 26 ft. to 87 ft., From _____ ft. to _____ ft.
 From _____ ft. to _____ ft., From _____ ft. to _____ ft.

6 GROUT MATERIAL: 1 Neat cement 2 Cement grout 3 Bentonite 4 Other _____

Grout intervals: From 6 ft. to 27 ft., From _____ ft. to _____ ft., From _____ ft. to _____ ft.

What is the nearest source of possible contamination:
 1 Septic tank 4 Lateral lines 7 Pit privy 10 Livestock pens 14 Abandoned water well
 2 Sewer lines 5 Cess pool 8 Sewage lagoon 11 Fuel storage 15 Oil well/Gas well
 3 Watertight sewer lines 6 Seepage pit 9 Feedyard 12 Fertilizer storage 16 Other (specify below)
 13 Insecticide storage

Direction from well? SOUTHEAST How many feet? 58

FROM	TO	LITHOLOGIC LOG	FROM	TO	PLUGGING INTERVALS
0	11	DARK SANDT & CLAY			
11	18	BROWN SANDY CLAY			
18	20	LITE COLOR CLAY & SHALE			
20	22	LITE GRAY CLAY			
22	37	RED CLAY & SHALE			
37	38	LITE GRAY CLAY			
38	40	LITE COLOR SHALE			
40	63	LIMESTONE			
63	73	LITE COLOR SHALE			
73	76	LIMESTONE & FLINT ROCK			
76	78	LITE COLOR SHALE			
78	84	GRAY CLAY & SHALE			
84	87	LITE COLOR CLAY & SHALE			

7 CONTRACTOR'S OR LANDOWNER'S CERTIFICATION: This water well was (1) constructed, (2) reconstructed, or (3) plugged under my jurisdiction and was completed on (mo/day/year) 2 / 1 / 90 and this record is true to the best of my knowledge and belief. Kansas Water Well Contractor's License No. 397 This Water Well Record was completed on (mo/day/yr) 3 / 15 / 90 under the business name of CENTRAL KANSAS DRILLING by (signature) Harold A. Martin

9000321005-22

OFFICE USE ONLY