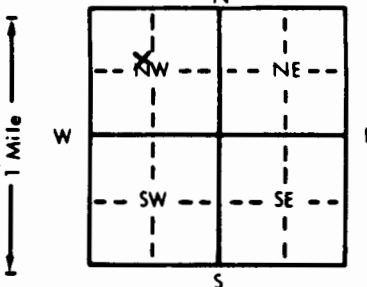


1 LOCATION OF WATER WELL: County: DICKENSON Fraction: SE 1/4 NW 1/4 NW 1/4 Section Number: 25 Township Number: T 13 S Range Number: R 3 E

Distance and direction from nearest town or city street address of well if located within city?  
From Enterprise go 3 miles East on County Road

2 WATER WELL OWNER: Tom Drehl  
 RR#, St. Address, Box #: RR1 Box 36A Board of Agriculture, Division of Water Resources  
 City, State, ZIP Code: Enterprise KS 67441 Application Number:

3 LOCATE WELL'S LOCATION WITH AN "X" IN SECTION BOX:  


4 DEPTH OF COMPLETED WELL: 100 ft. ELEVATION:  
 Depth(s) Groundwater Encountered: 1 40 75 ft. 2. .... ft. 3. .... ft.  
 WELL'S STATIC WATER LEVEL: 40 ft. below land surface measured on mo/day/yr  
 Pump test data: Well water was ..... ft. after ..... hours pumping ..... gpm  
 Est. Yield: 100 gpm; Well water was ..... ft. after ..... hours pumping ..... gpm  
 Bore Hole Diameter: 8 in. to 100 ft., and ..... in. to ..... ft.  
 WELL WATER TO BE USED AS:  
 1 Domestic     3 Feedlot     6 Oil field water supply     9 Dewatering     12 Other (Specify below)  
 2 Irrigation     4 Industrial     7 Lawn and garden only     10 Monitoring well  
 Was a chemical/bacteriological sample submitted to Department? Yes..... No X.....; If yes, mo/day/yr sample was submitted  
 Water Well Disinfected? Yes No

5 TYPE OF BLANK CASING USED:  
 1 Steel     3 RMP (SR)     5 Wrought iron     8 Concrete tile    CASING JOINTS: Glued Clamped  
 2 PVC     4 ABS     6 Asbestos-Cement     9 Other (specify below)     Welded  
 Blank casing diameter: 5 in. to 80 ft., Dia. .... in. to ..... ft., Dia. .... in. to ..... ft.  
 Casing height above land surface: 24 in., weight 5ch 40 lbs./ft. Wall thickness or gauge No. ....  
 TYPE OF SCREEN OR PERFORATION MATERIAL:  
 1 Steel     3 Stainless steel     5 Fiberglass     8 RMP (SR)     10 Asbestos-cement  
 2 Brass     4 Galvanized steel     6 Concrete tile     9 ABS     11 Other (specify) .....  
 12 None used (open hole)  
 SCREEN OR PERFORATION OPENINGS ARE:  
 1 Continuous slot     3 Mill slot 31/1000     5 Gauzed wrapped     8 Saw cut     11 None (open hole)  
 2 Louvered shutter     4 Key punched     6 Wire wrapped     9 Drilled holes  
 7 Torch cut     10 Other (specify) .....  
 SCREEN-PERFORATED INTERVALS: From 80 ft. to 100 ft., From ..... ft. to ..... ft.  
 GRAVEL PACK INTERVALS: From 20 ft. to 100 ft., From ..... ft. to ..... ft.

6 GROUT MATERIAL:  1 Neat cement     2 Cement grout     3 Bentonite Evidence Plug     4 Other  
 Grout Intervals: From 0 ft. to 20 ft., From ..... ft. to ..... ft., From ..... ft. to ..... ft.  
 What is the nearest source of possible contamination:  
 1 Septic tank     4 Lateral lines     7 Pit privy     10 Livestock pens     14 Abandoned water well  
 2 Sewer lines     5 Cess pool     8 Sewage lagoon     11 Fuel storage     15 Oil well/Gas well  
 3 Watertight sewer lines     6 Seepage pit     9 Feedyard     12 Fertilizer storage     16 Other (specify below)  
 13 Insecticide storage  
 Direction from well? South How many feet? 200'

FROM	TO	LITHOLOGIC LOG	FROM	TO	PLUGGING INTERVALS
0	4	GRAY SHALE			
4	8	lime stone			
8	18	yellow shale			
18	19	lime stone			
19	30	yellow shale			
30	38	Redish Brown shale			
38	61	lime stone			
61	67	yellow shale			
67	77	lime stone			
77	85	GRAY SHALE			
85	91	lime stone			
91	100	GRAY SHALE			

7 CONTRACTOR'S OR LANDOWNER'S CERTIFICATION: This water well was (1) constructed (2) reconstructed, or (3) plugged under my jurisdiction and was completed on (mo/day/year) 7/5/89 and this record is true to the best of my knowledge and belief. Kansas Water Well Contractor's License No. 451 This Water Well Record was completed on (mo/day/yr) 8/29/89 under the business name of Haldeman well Drilling by (signature) Craig H