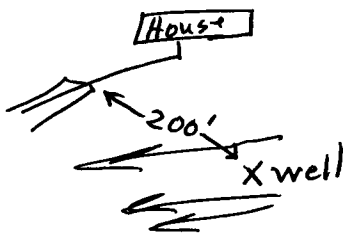


USE TYPEWRITER OR BALL POINT PEN-PRESS FIRMLY, PRINT CLEARLY.

WATER WELL RECORD
KSA 82a-1201-1215

Kansas Department of Health and Environment
Division of Environment
(Water well Contractors)
Topeka, Kansas 66620

1. Location of well:		County Dickinson	Fraction NE 1/4 NE 1/4 NW 1/4	Section number 27	Township number T 13 S R	Range number 3 EW
2. Distance and direction from nearest town or city: Street address of well location if in city:			3. Owner of well: R.R. or street: City, state, zip code:			
4. Locate with "X" in section below: N W E S 1 Mile			Sketch map: 		6. Bore hole dia. 6 1/2 in. Completion date 6-30-78 Well depth 89 ft.	
5. Type and color of material			From	To	7. <input checked="" type="checkbox"/> Cable tool <input type="checkbox"/> Rotary <input type="checkbox"/> Driven <input type="checkbox"/> Dug <input type="checkbox"/> Hollow rod <input type="checkbox"/> Jetted <input type="checkbox"/> Bored <input type="checkbox"/> Reverse rotary	
Topsoil			0	2	8. Use: <input checked="" type="checkbox"/> Domestic <input type="checkbox"/> Public supply <input type="checkbox"/> Industry <input type="checkbox"/> Irrigation <input type="checkbox"/> Air conditioning <input type="checkbox"/> Stock <input type="checkbox"/> Lawn <input type="checkbox"/> Oil field water <input type="checkbox"/> Other	
Clay - Brn			2	9	9. Casing: Material PLS Height: Above or below Threaded <input type="checkbox"/> Welded glw Surface 18 in. RMP <input checked="" type="checkbox"/> PVC <input type="checkbox"/> Weight _____ lbs./ft. Dia. 5 in. to 70 ft. depth Wall Thickness: inches or Dia. _____ in. to _____ ft. depth gage No. 200	
Broken LIME - TAN			9	12	10. Screen: Manufacturer's name Sunflower	
LIME TAN			12	20	Type RMP Dia. 5 1/2 <input checked="" type="checkbox"/> gauze Y Length 19 Set between 70 ft. and 89 ft. _____ ft. and _____ ft. Gravel pack? <input checked="" type="checkbox"/> Size range of material Y-3/8	
Dry Crevice			20	33	11. Static water level: _____ mo./day/yr. 56 ft. below land surface Date 6-30-78	
Shale & Broken lime Yel			33	36	12. Pumping level below land surfaces: _____ ft. after _____ hrs. pumping _____ g.p.m. _____ ft. after _____ hrs. pumping _____ g.p.m. Estimated maximum yield 10 g.p.m.	
LIME Yel			36	40	13. Water sample submitted: _____ mo./day/yr. Yes <input type="checkbox"/> No <input checked="" type="checkbox"/> Date _____	
Shale - Yel			40	44	14. Well head completion: <input type="checkbox"/> Pitless adapter 18 inches above grade	
LIME Yel			44	49	15. Well grouted? Yes With: <input type="checkbox"/> Neat cement <input type="checkbox"/> Bentonite <input checked="" type="checkbox"/> Concrete Depth: From 3 ft. to 13 ft.	
Shale - Light Blue			49	51	16. Nearest source of possible contamination: ft. 200 Direction NW Type sewage Well disinfected upon completion? <input checked="" type="checkbox"/> Yes <input type="checkbox"/> No	
Red Rock			51	75	17. Pump: <input checked="" type="checkbox"/> Not installed	
LIME			75	82	Manufacturer's name _____ Model number _____ HP _____ Volts _____ Length of drop pipe _____ ft. capacity _____ g.p.m. Type: <input type="checkbox"/> Submersible <input type="checkbox"/> Turbine <input type="checkbox"/> Jet <input type="checkbox"/> Reciprocating <input type="checkbox"/> Centrifugal <input type="checkbox"/> Other	
Shale			82	84	20. Water well contractor's certification: This well was drilled under my jurisdiction and this report is true to the best of my knowledge and belief. Zinn Water Well Dng 218 Business name _____ License No. _____ Address Lost Springs, Ks Signed Joseph A. Zinn Date 8-22-78 Authorized representative	
LIME			84	86		
Shale			86	88		
(Use a second sheet if needed)						
18. Elevation:		19. Remarks:				
Topography: <input type="checkbox"/> Hill <input checked="" type="checkbox"/> Slope <input checked="" type="checkbox"/> Upland <input type="checkbox"/> Valley						

T 13 R 3 W 22 NE 1/4 NW 1/4

Forward the white, blue and pink copies to the Department of Health and Environment

Form WWC-5