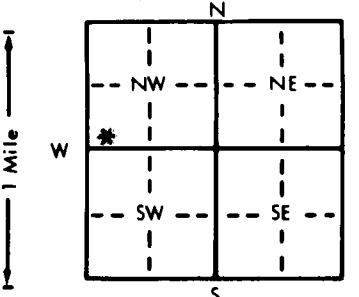


1 LOCATION OF WATER WELL: Fraction SW 1/4 SW 1/4 NW 1/4 Section Number 28 Township Number T 13 S Range Number R 3 **E/W**

Distance and direction from nearest town or city street address of well if located within city?
South of Enterprise, Ks on Hwy 43 7/16 miles

2 WATER WELL OWNER: Charles Jones
 RR#, St. Address, Box # : Rt 1, Box 79 Board of Agriculture, Division of Water Resources
 City, State, ZIP Code : Enterprise, Kansas 67441 Application Number:

3 LOCATE WELL'S LOCATION WITH AN "X" IN SECTION BOX:


4 DEPTH OF COMPLETED WELL: 85 ft. ELEVATION:
 Depth(s) Groundwater Encountered 1. 67 ft. 2. 65 ft. 3. 11 ft.
 WELL'S STATIC WATER LEVEL 65 ft. below land surface measured on mo/day/yr 11 / 9 / 89
 Pump test data: Well water was 15 ft. after 11 hours pumping 15 gpm
 Est. Yield 15 gpm: Well water was 11 ft. after 9 hours pumping 15 gpm
 Bore Hole Diameter 9 in. to 85 ft., and 9 in. to 85 ft.
 WELL WATER TO BE USED AS:
 1 Domestic 3 Feedlot 6 Oil field water supply 9 Dewatering 12 Other (Specify below)
 2 Irrigation 4 Industrial 7 Lawn and garden only 10 Monitoring well
 Was a chemical/bacteriological sample submitted to Department? Yes * No *; If yes, mo/day/yr sample was submitted
 Water Well Disinfected? Yes * No

5 TYPE OF BLANK CASING USED:
 1 Steel 3 RMP (SR) 5 Wrought iron 8 Concrete tile CASING JOINTS: Glued * Clamped
 2 PVC 4 ABS 6 Asbestos-Cement 9 Other (specify below) Welded
 7 Fiberglass Threaded
 Blank casing diameter 5 in. to 85 ft., Dia 5 in. to 85 ft., Dia 5 in. to 85 ft.
 Casing height above land surface 14 in., weight 160 lbs./ft. Wall thickness or gauge No. 214
 TYPE OF SCREEN OR PERFORATION MATERIAL:
 1 Steel 3 Stainless steel 5 Fiberglass 8 RMP (SR) 10 Asbestos-cement
 2 Brass 4 Galvanized steel 6 Concrete tile 9 ABS 11 Other (specify)
 12 None used (open hole)
 SCREEN OR PERFORATION OPENINGS ARE:
 1 Continuous slot 3 Mill slot 5 Gauzed wrapped 8 Saw cut 11 None (open hole)
 2 Louvered shutter 4 Key punched 6 Wire wrapped 9 Drilled holes
 7 Torch cut 10 Other (specify)
 SCREEN-PERFORATED INTERVALS: From 65 ft. to 85 ft., From 65 ft. to 85 ft., From 65 ft. to 85 ft.
 GRAVEL PACK INTERVALS: From 25 ft. to 85 ft., From 25 ft. to 85 ft., From 25 ft. to 85 ft.

6 GROUT MATERIAL: 1 Neat cement 2 Cement grout 3 Bentonite 4 Other
 Grout Intervals: From 4 ft. to 25 ft., From 4 ft. to 25 ft., From 4 ft. to 25 ft.
 What is the nearest source of possible contamination:
 1 Septic tank 4 Lateral lines 7 Pit privy 10 Livestock pens 14 Abandoned water well
 2 Sewer lines 5 Cess pool 8 Sewage lagoon 11 Fuel storage 15 Oil well/Gas well
 3 Watertight sewer lines 6 Seepage pit 9 Feedyard 12 Fertilizer storage 16 Other (specify below)
 13 Insecticide storage
 Direction from well? NORTH How many feet? 120

FROM	TO	LITHOLOGIC LOG	FROM	TO	PLUGGING INTERVALS
0	1	DARK TOP SOIL	84	85	LIMESTONE
1	7	LITE COLOR SHALEY CLAY			
7	10	LIMESTONE			
10	15	LITE COLOR SHALE & CLAY			
15	16	LIMESTONE			
16	25	LITE COLOR CLAY & SHALE			
25	29	LIMESTONE			
29	35	LITE COLOR SHALE			
35	48	RED CLAY & SHALE			
48	51	LITE GRAY SHALE			
51	56	LITE COLOR SHALE			
56	63	LIMESTONE			
63	65	LITE COLOR SHALE			
65	72	LIMESTONE			
72	84	LITE COLOR SHALE			

7 CONTRACTOR'S OR LANDOWNER'S CERTIFICATION: This water well was (1) constructed, (2) reconstructed, or (3) plugged under my jurisdiction and was completed on (mo/day/year) 11 / 9 / 89 and this record is true to the best of my knowledge and belief. Kansas Water Well Contractor's License No. 397 This Water Well Record was completed on (mo/day/yr) 1 / 22 / 90 under the business name of CENTRAL KANSAS DRILLING by (signature) Harold D. Martin

INSTRUCTIONS: Use typewriter or ball point pen. PLEASE PRESS FIRMLY and PRINT clearly. Please fill in blanks, underline or circle the correct answers. Send top three copies to Kansas Department of Health and Environment, Bureau of Water Protection, Topeka, Kansas 66620-7320. Telephone: 913-296-5514. Send one to WATER WELL OWNER and retain one for your records.

22-8902354408