


1 LOCATION OF WATER WELL: County: Dickinson Fraction: NW 1/4 SW 1/4 NW 1/4 Section Number: 29 Township Number: T 13 S Range Number: R 3 E

Distance and direction from nearest town or city street address of well if located within city?
4 S Enterprise

2 WATER WELL OWNER: Enterprise Academy Farm Well
 RR#, St. Address, Box #: S Bluff
 City, State, ZIP Code: Enterprise, KS 67441
 Board of Agriculture, Division of Water Resources
 Application Number:

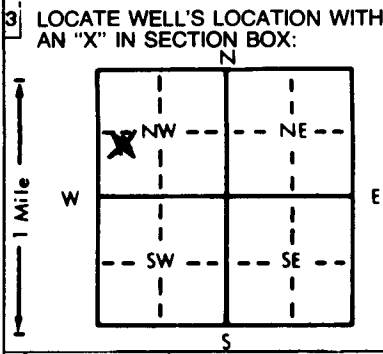

4 DEPTH OF COMPLETED WELL: 89 ft. ELEVATION:
 Depth(s) Groundwater Encountered: 1. 79 ft. 2. ft. 3. ft.
 WELL'S STATIC WATER LEVEL: 63 ft. below land surface measured on mo/day/yr 10-9-91
 Pump test data: Well water was ft. after hours pumping gpm
 Est. Yield: 20 gpm Well water was ft. after hours pumping gpm
 Bore Hole Diameter: 8 1/2 in. to 8 9 in. and in. to ft.
 WELL WATER TO BE USED AS:
 1 Domestic 3 Feedlot 6 Oil field water supply 9 Dewatering 12 Other (Specify below)
 2 Irrigation 4 Industrial 7 Lawn and garden only 10 Monitoring well
 Was a chemical/bacteriological sample submitted to Department? Yes.....No. X.....; If yes, mo/day/yr sample was submitted
 Water Well Disinfected? Yes X No

5 TYPE OF BLANK CASING USED:
 1 Steel 3 RMP (SR) 5 Wrought iron 8 Concrete tile CASING JOINTS: Glued X Clamped
 2 PVC 4 ABS 6 Asbestos-Cement 9 Other (specify below) Welded
 7 Fiberglass Threaded.....
 Blank casing diameter: 5 in. to 6 9 ft. Dia. in. to ft. Dia. in. to ft.
 Casing height above land surface: 12 in. weight CLASS 160 lbs./ft. Wall thickness or gauge No. 2 1/4
 TYPE OF SCREEN OR PERFORATION MATERIAL:
 1 Steel 3 Stainless steel 5 Fiberglass 7 PVC 10 Asbestos-cement
 2 Brass 4 Galvanized steel 6 Concrete tile 8 RMP (SR) 11 Other (specify)
 9 ABS 12 None used (open hole)
 SCREEN OR PERFORATION OPENINGS ARE:
 1 Continuous slot 3 Mill slot 5 Gauzed wrapped 8 Saw cut 11 None (open hole)
 2 Louvered shutter 4 Key punched 6 Wire wrapped 9 Drilled holes
 7 Torch cut 10 Other (specify)
 SCREEN-PERFORATED INTERVALS: From 69 ft. to 89 ft., From ft. to ft.
 From ft. to ft., From ft. to ft.
 GRAVEL PACK INTERVALS: From 24 ft. to 89 ft., From ft. to ft.
 From ft. to ft., From ft. to ft.

6 GROUT MATERIAL: 1 Neat cement 2 Cement grout 3 Bentonite 4 Other
 Grout Intervals: From 4 ft. to 24 ft., From ft. to ft., From ft. to ft.
 What is the nearest source of possible contamination:
 1 Septic tank 4 Lateral lines 7 Pit privy 10 Livestock pens 14 Abandoned water well
 2 Sewer lines 5 Cess pool 8 Sewage lagoon 11 Fuel storage 15 Oil well/Gas well
 3 Watertight sewer lines 6 Seepage pit 9 Feedyard 12 Fertilizer storage 16 Other (specify below)
 13 Insecticide storage
 Direction from well? How many feet? None Within 500'

FROM	TO	LITHOLOGIC LOG	FROM	TO	PLUGGING INTERVALS
0	2	Clay			
2	15	Lime			
15	21	Yellow Shale			
21	32	Lime			
32	45	Red Shale			
45	79	Lime & mixed Shale			
79	80	Water			
80	84	Lime			
84	89	Blue Shale			

7 CONTRACTOR'S OR LANDOWNER'S CERTIFICATION: This water well was (1) constructed, (2) reconstructed, or (3) plugged under my jurisdiction and was completed on (mo/day/year) 10-9-91 and this record is true to the best of my knowledge and belief. Kansas Water Well Contractor's License No. 180 This Water Well Record was completed on (mo/day/year) 10-11-91 under the business name of Backhus Drilling by (signature) Paul H. Backhus