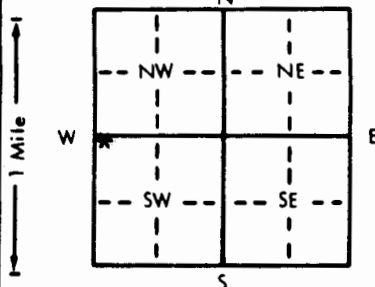


1 LOCATION OF WATER WELL: Fraction NW 1/4 NW 1/4 SW 1/4 Section Number 30 Township Number T 13 S Range Number R 3 E  
 County: Dickinson

Distance and direction from nearest town or city street address of well if located within city?  
1/2 mile South of Enterprise, Ks & 1 1/2 mile West & 1/2 mile South

2 WATER WELL OWNER: Charles Bankes  
 RR#, St. Address, Box # : Rt 1 Board of Agriculture, Division of Water Resources  
 City, State, ZIP Code : Enterprise, Kansas 67441 Application Number:

3 LOCATE WELL'S LOCATION WITH AN "X" IN SECTION BOX:  
  
 4 DEPTH OF COMPLETED WELL: 96 ft. ELEVATION:  
 Depth(s) Groundwater Encountered 1. 70 ft. 2. ft. 3. ft.  
 WELL'S STATIC WATER LEVEL 66 ft. below land surface measured on mo/day/yr 5 / 23 / 89  
 Pump test data: Well water was ft. after hours pumping gpm  
 Est. Yield 25 gpm: Well water was ft. after hours pumping gpm  
 Bore Hole Diameter 9 in. to 96 ft., and in. to ft.  
 WELL WATER TO BE USED AS: 5 Public water supply 8 Air conditioning 11 Injection well  
1 Domestic 3 Feedlot 6 Oil field water supply 9 Dewatering 12 Other (Specify below)  
 2 Irrigation 4 Industrial 7 Lawn and garden only 10 Monitoring well  
 Was a chemical/bacteriological sample submitted to Department? Yes.....No.....\*  
 Water Well Disinfected? Yes \* No

5 TYPE OF BLANK CASING USED:  
 1 Steel 3 RMP (SR) 5 Wrought iron 8 Concrete tile CASING JOINTS: Glued \* Clamped  
 2 PVC 4 ABS 6 Asbestos-Cement 9 Other (specify below) Welded  
 7 Fiberglass Threaded  
 Blank casing diameter 5 in. to 96 ft., Dia in. to ft., Dia in. to ft.  
 Casing height above land surface 14 in., weight 160 lbs./ft. Wall thickness or gauge No. 214  
 TYPE OF SCREEN OR PERFORATION MATERIAL:  
 1 Steel 3 Stainless steel 5 Fiberglass 7 PVC 10 Asbestos-cement  
 2 Brass 4 Galvanized steel 6 Concrete tile 8 RMP (SR) 11 Other (specify)  
 9 ABS 12 None used (open hole)  
 SCREEN OR PERFORATION OPENINGS ARE:  
 1 Continuous slot 3 Mill slot 5 Gauzed wrapped 8 Saw cut 11 None (open hole)  
 2 Louvered shutter 4 Key punched 6 Wire wrapped 9 Drilled holes  
 7 Torch cut 10 Other (specify)  
 SCREEN-PERFORATED INTERVALS: From 66 ft. to 96 ft., From ft. to ft.  
 From ft. to ft., From ft. to ft.  
 GRAVEL PACK INTERVALS: From 28 ft. to 96 ft., From ft. to ft.  
 From ft. to ft., From ft. to ft.

6 GROUT MATERIAL: 1 Neat cement 2 Cement grout 3 Bentonite 4 Other  
 Grout intervals: From 4 ft. to 28 ft., From ft. to ft., From ft. to ft.  
 What is the nearest source of possible contamination:  
 1 Septic tank 4 Lateral lines 7 Pit privy 10 Livestock pens 14 Abandoned water well  
 2 Sewer lines 5 Cess pool 8 Sewage lagoon 11 Fuel storage 15 Oil well/Gas well  
 3 Watertight sewer lines 6 Seepage pit 9 Feedyard 12 Fertilizer storage 16 Other (specify below)  
 13 Insecticide storage  
 Direction from well? WEST How many feet? APPROX 300

FROM	TO	LITHOLOGIC LOG	FROM	TO	PLUGGING INTERVALS
0	2	BROWN CLAY			
2	10	LIMESTONE			
10	19	GRAY SHALE			
19	22	LIMESTONE			
22	30	LITE COLOR SHALE			
30	43	RED SHALE			
43	46	GRAY SHALE & RED SHALE MIXED			
46	49	LIMESTONE			
49	50	LITE COLOR SHALE			
50	64	LIMESTONE			
64	70	DARK LIMESTONE			
70	74	SOFT LITE COLOR SHALE			
74	83	LITE GRAY CLAY SHALE			
83	85	DARK FLINT			
85	96	GRAY SHALE & CLAY			

7 CONTRACTOR'S OR LANDOWNER'S CERTIFICATION: This water well was (1) constructed, (2) reconstructed, or (3) plugged under my jurisdiction and was completed on (mo/day/year) 5 / 23 / 89 and this record is true to the best of my knowledge and belief. Kansas Water Well Contractor's License No. 397 This Water Well Record was completed on (mo/day/yr) 6 / 13 / 89 under the business name of CENTRAL KANSAS DRILLING by (signature) Harold D. Martin

INSTRUCTIONS: Use typewriter or ball point pen. PLEASE PRESS FIRMLY and PRINT clearly. Please fill in blanks, underline or circle the correct answers. Send top three copies to Kansas Department of Health and Environment, Bureau of Water Protection, Topeka, Kansas 66620-7320. Telephone: 913-296-5514. Send one to WATER WELL OWNER and retain one for your records.

0600000088-82