


1 LOCATION OF WATER WELL: Fraction NE 1/4 NE 1/4 NE 1/4 Section Number 30 Township Number T 13 S Range Number R 3 EW*
 County: Dickinson

Distance and direction from nearest town or city street address of well if located within city?
1/2 mile West of Enterprise, Kansas

2 WATER WELL OWNER: Ervin Aebi
 RR#, St. Address, Box #: Rt 1, Box 4 Board of Agriculture, Division of Water Resources
 City, State, ZIP Code: Enterprise, Kansas 67441 Application Number:

3 LOCATE WELL'S LOCATION WITH AN "X" IN SECTION BOX:

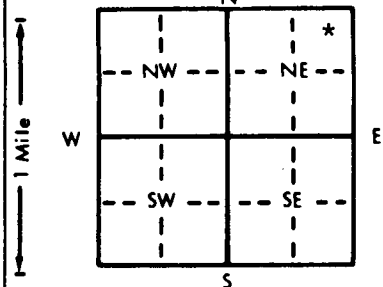

4 DEPTH OF COMPLETED WELL: 120 ft. ELEVATION:
 Depth(s) Groundwater Encountered 1. 57 ft. 2. _____ ft. 3. _____ ft.
 WELL'S STATIC WATER LEVEL 52 ft. below land surface measured on mo/day/yr 2 / 15 / 94
 Pump test data: Well water was _____ ft. after _____ hours pumping _____ gpm
 Est. Yield 20 gpm: Well water was _____ ft. after _____ hours pumping _____ gpm
 Bore Hole Diameter 9 in. to 120 ft., and _____ in. to _____ ft.
 WELL WATER TO BE USED AS:
 5 Public water supply 8 Air conditioning 11 Injection well
 1 Domestic 3 Feedlot 6 Oil field water supply 9 Dewatering 12 Other (Specify below)
 2 Irrigation 4 Industrial 7 Lawn and garden only 10 Monitoring well
 Was a chemical/bacteriological sample submitted to Department? Yes _____ No *; If yes, mo/day/yr sample was submitted
 Water Well Disinfected? Yes * No

5 TYPE OF BLANK CASING USED:
 1 Steel 3 RMP (SR) 5 Wrought iron 8 Concrete tile CASING JOINTS: Glued * Clamped _____
 2 PVC 4 ABS 6 Asbestos-Cement 9 Other (specify below) Welded _____
 7 Fiberglass Threaded _____
 Blank casing diameter 5 in. to 120 ft., Dia _____ in. to _____ ft., Dia _____ in. to _____ ft.
 Casing height above land surface 16 in., weight 200 lbs./ft. Wall thickness or gauge No. _____
 TYPE OF SCREEN OR PERFORATION MATERIAL:
 1 Steel 3 Stainless steel 5 Fiberglass 7 PVC 10 Asbestos-cement
 2 Brass 4 Galvanized steel 6 Concrete tile 8 RMP (SR) 11 Other (specify) _____
 9 ABS 12 None used (open hole)
 SCREEN OR PERFORATION OPENINGS ARE:
 1 Continuous slot 3 Mill slot 5 Gauzed wrapped 8 Saw cut 11 None (open hole)
 2 Louvered shutter 4 Key punched 6 Wire wrapped 9 Drilled holes
 7 Torch cut 10 Other (specify) _____
 SCREEN-PERFORATED INTERVALS: From 53 ft. to 120 ft., From _____ ft. to _____ ft.
 From _____ ft. to _____ ft., From _____ ft. to _____ ft.
 GRAVEL PACK INTERVALS: From 24 ft. to 120 ft., From _____ ft. to _____ ft.
 From _____ ft. to _____ ft., From _____ ft. to _____ ft.

6 GROUT MATERIAL: 1 Neat cement 2 Cement grout 3 Bentonite 4 Other _____
 Grout intervals: From 3 ft. to 24 ft., From _____ ft. to _____ ft., From _____ ft. to _____ ft.
 What is the nearest source of possible contamination:
 1 Septic tank 4 Lateral lines 7 Pit privy 10 Livestock pens 14 Abandoned water well
 2 Sewer lines 5 Cess pool 8 Sewage lagoon 11 Fuel storage 15 Oil well/Gas well
 3 Watertight sewer lines 6 Seepage pit 9 Feedyard 12 Fertilizer storage 16 Other (specify below)
 13 Insecticide storage
 Direction from well NORTHEAST How many feet? 93

FROM	TO	LITHOLOGIC LOG	FROM	TO	PLUGGING INTERVALS
0	1	DARK TOP SOIL	80	87	GRAY SHALE & CLAY
1	2	BROWN CLAY	87	90	LITE COLOR SHALE & LIMESTONE
2	3	LITE COLOR CLAY & ROCK	90	94	GRAY CLAY
3	8	LITE COLOR LIMESTONE	94	110	RED CLAY
8	18	LITE COLOR SHALEY CLAY	110	114	TAN LIMESTONE
18	20	LITE COLOR LIMESTONE	114	120	GRAY LIMESTONE
20	27	LITE GRAY SHALE			
27	39	RED CLAY & SHALE			
39	45	LITE GRAY SHALE			
45	48	LITE COLOR LIMESTONE			
48	50	LITE COLOR SHALE			
50	61	LITE COLOR LIMESTONE			
61	73	LITE COLOR SHALE & CLAY			
73	76	LITE COLOR LIMESTONE & FLINT ROCK			
76	80	LITE COLOR SHALE & CLAY			

7 CONTRACTOR'S OR LANDOWNER'S CERTIFICATION: This water well was (1) constructed, (2) reconstructed, or (3) plugged under my jurisdiction and was completed on (mo/day/year) 2 / 15 / 94 and this record is true to the best of my knowledge and belief. Kansas Water Well Contractor's License No. 397 This Water Well Record was completed on (mo/day/yr) 2 / 18 / 94 under the business name of CENTRAL KANSAS DRILLING by (signature) Harold D. Martin

INSTRUCTIONS: Use typewriter or ball point pen. PLEASE PRESS FIRMLY and PRINT clearly. Please fill in blanks, underline or circle the correct answers. Send top three copies to Kansas Department of Health and Environment, Bureau of Water, Topeka, Kansas 66620-0001. Telephone: 913-296-5545. Send one to WATER WELL OWNER and retain one for your records.

000350