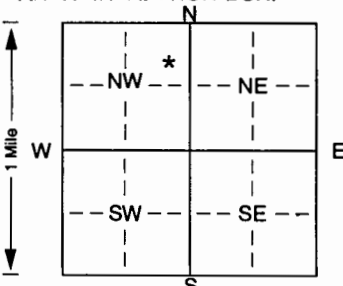


1 LOCATION OF WATER WELL: Fraction NE 1/4 NE 1/4 NW 1/4 Section Number 23 Township Number T 13 S Range Number R 3 E/W
 County: Dickinson

Distance and direction from nearest town or city street address of well if located within city?
2 1/2 miles East of Enterprise, Ks. 1 mile North & 3/8 mile East on 2200 Ave.

2 WATER WELL OWNER: Curt Thomas
 RR#, St. Address, Box # : 500 Layton Lane Board of Agriculture, Division of Water Resources
 City, State, ZIP Code : Enterprise, Kansas 67441 Application Number:

3 LOCATE WELL'S LOCATION WITH AN "X" IN SECTION BOX:

 4 DEPTH OF COMPLETED WELL: 133 ft. ELEVATION:
 Depth(s) Groundwater Encountered 1. 96 ft. 2. 96 ft. 3. 96 ft.
 WELL'S STATIC WATER LEVEL 9.0 ft. below land surface measured on mo/day/yr 9 / 2 / 00
 Pump test data: Well water was _____ ft. after _____ hours pumping _____ gpm
 Est. Yield 1.5 gpm: Well water was _____ ft. after _____ hours pumping _____ gpm
 Bore Hole Diameter. 9 in. to 133 ft., and _____ in. to _____ ft.
 WELL WATER TO BE USED AS: 5 Public water supply 8 Air conditioning 11 Injection well
1 Domestic 3 Feedlot 6 Oil field water supply 9 Dewatering 12 Other (Specify below)
 2 Irrigation 4 Industrial 7 Domestic (lawn & garden) 10 Monitoring well _____
 Was a chemical/bacteriological sample submitted to Department? Yes. _____ No. *; If yes, mo/day/yr sample was submitted
 Water Well Disinfected? Yes * No

5 TYPE OF BLANK CASING USED:
 1 Steel 3 RMP (SR) 5 Wrought iron 8 Concrete tile CASING JOINTS: Glued. * Clamped. _____
 2 PVC 4 ABS 6 Asbestos-Cement 9 Other (specify below) Welded _____
 7 Fiberglass Threaded. _____
 Blank casing diameter 5 in. to 133 ft., Dia _____ in. to _____ ft., Dia _____ in. to _____ ft.
 Casing height above land surface. 18 in., weight SCH. 40 lbs./ft. Wall thickness or gauge No. 190
 TYPE OF SCREEN OR PERFORATION MATERIAL:
 1 Steel 3 Stainless steel 5 Fiberglass 7 PVC 10 Asbestos-cement
 2 Brass 4 Galvanized steel 6 Concrete tile 8 RMP (SR) 11 Other (specify) _____
 9 ABS 12 None used (open hole)
 SCREEN OR PERFORATION OPENINGS ARE:
 1 Continuous slot 3 Mill slot 5 Gauzed wrapped 8 Saw cut 11 None (open hole)
 2 Louvered shutter 4 Key punched 6 Wire wrapped 9 Drilled holes
 7 Torch cut 10 Other (specify) _____ ft.
 SCREEN-PERFORATED INTERVALS: From 9.3 ft. to 133 ft., From _____ ft. to _____ ft.
 From _____ ft. to _____ ft., From _____ ft. to _____ ft.
 GRAVEL PACK INTERVALS: From 24 ft. to 133 ft., From _____ ft. to _____ ft.
 From _____ ft. to _____ ft., From _____ ft. to _____ ft.

6 GROUT MATERIAL: 1 Neat cement 2 Cement grout 3 Bentonite 4 Other _____
 Grout Intervals: From 3 ft. to 24 ft., From _____ ft. to _____ ft., From _____ ft. to _____ ft.
 What is the nearest source of possible contamination:
 1 Septic tank 4 Lateral lines 7 Pit privy 10 Livestock pens 14 Abandoned water well
 2 Sewer lines 5 Cess pool 8 Sewage lagoon 11 Fuel storage 15 Oil well/Gas well
 3 Watertight sewer lines 6 Seepage pit 9 Feedyard 12 Fertilizer storage 16 Other (specify below)
 13 Insecticide storage _____
 Direction from well? SOUTHEAST WILL BE APPROX How many feet? 100+

FROM	TO	LITHOLOGIC LOG	FROM	TO	PLUGGING INTERVALS
0	2	DARK TOP SOIL			
2	5	BROWN CLAY			
5	10	LITE COLOR CLAY & SHALE			
10	23	MAROON & RED CLAY & SHALE			
23	29	LITE GRAY SHALE			
29	43	LITE COLOR LIMESTONE			
43	53	LITE COLOR SHALE			
53	58	LITE COLOR LIMESTONE			
58	70	LITE COLOR SHALE			
70	94	RED SHALE			
94	96	LITE COLOR SHALE			
96	107	LITE COLOR LIMESTONE			
107	124	GRAY CLAY & SHALE			
124	133	HARD GRAY LIMESTONE			

7 CONTRACTOR'S OR LANDOWNER'S CERTIFICATION: This water well was (1) constructed, (2) reconstructed, or (3) plugged under my jurisdiction and was completed on (mo/day/year) 9 / 2 / 00 and this record is true to the best of my knowledge and belief. Kansas Water Well Contractor's Licence No. 397. This Water Well Record was completed on (mo/day/yr) 9 / 9 / 00 under the business name of CENTRAL KANSAS DRILLING by (signature) Harold D. Martin