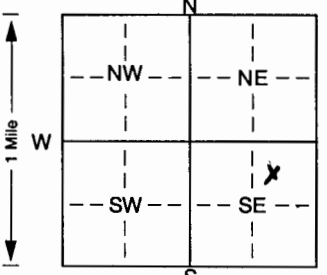


1 LOCATION OF WATER WELL: Fraction NW 1/4 NE 1/4 SE 1/4 Section Number 26 Township Number T 13 S Range Number R 3 E  
 County: Dickerson

Distance and direction from nearest town or city street address of well if located within city? 3 miles east of Enterprise & 1/2 mile south 2049 Paint Rd.

2 WATER WELL OWNER: Clay Decker  
 RR#, St. Address, Box #: 2049 Paint Rd. Board of Agriculture, Division of Water Resources  
 City, State, ZIP Code: Enterprise, Ks. 67441 Application Number:

3 LOCATE WELL'S LOCATION WITH AN "X" IN SECTION BOX:  4 DEPTH OF COMPLETED WELL: 120' ft. ELEVATION: ..... ft.  
 Depth(s) Groundwater Encountered 1.66' ft. 2. .... ft. 3. .... ft.  
 WELL'S STATIC WATER LEVEL 40' ft. below land surface measured on mo/day/yr ..... ft.  
 Pump test data: Well water was ..... ft. after ..... hours pumping ..... gpm  
 Est. Yield 200 gpm: Well water was ..... ft. after ..... hours pumping ..... gpm  
 Bore Hole Diameter 9 in. to ..... ft., and ..... in. to ..... ft.  
 WELL WATER TO BE USED AS: 5 Public water supply 8 Air conditioning 11 Injection well  
1 Domestic 3 Feedlot 6 Oil field water supply 9 Dewatering 12 Other (Specify below)  
2 Irrigation 4 Industrial 7 Domestic (lawn & garden) 10 Monitoring well .....  
 Was a chemical/bacteriological sample submitted to Department? Yes. .... No. .... ; If yes, mo/day/yr sample was submitted  
 Water Well Disinfected? Yes No

5 TYPE OF BLANK CASING USED: 5 Wrought iron 8 Concrete tile CASING JOINTS: Glued Clamped .....  
2 PVC 3 RMP (SR) 6 Asbestos-Cement 9 Other (specify below) Welded .....  
 4 ABS 7 Fiberglass Threaded .....  
 Blank casing diameter 5 in. to 80 ft., Dia ..... in. to ..... ft., Dia ..... in. to ..... ft.  
 Casing height above land surface 2 in., weight 5 lb. 40 lbs./ft. Wall thickness or gauge No. ....  
 TYPE OF SCREEN OR PERFORATION MATERIAL: PVC 10 Asbestos-cement  
 1 Steel 3 Stainless steel 5 Fiberglass 8 RMP (SR) 11 Other (specify) .....  
 2 Brass 4 Galvanized steel 6 Concrete tile 9 ABS 12 None used (open hole)  
 SCREEN OR PERFORATION OPENINGS ARE: 5 Gauzed wrapped 8 Saw cut 11 None (open hole)  
 1 Continuous slot 3 Mill slot 25000 6 Wire wrapped 9 Drilled holes  
 2 Louvered shutter 4 Key punched 7 Torch cut 10 Other (specify) ..... ft.  
 SCREEN-PERFORATED INTERVALS: From 80 ft. to 100 ft., From ..... ft. to ..... ft.  
 From ..... ft. to ..... ft., From ..... ft. to ..... ft.  
 GRAVEL PACK INTERVALS: From 25 ft. to 100 ft., From ..... ft. to ..... ft.  
 From ..... ft. to ..... ft., From ..... ft. to ..... ft.

6 GROUT MATERIAL: 1 Neat cement 2 Cement grout 3 Bentonite 4 Other .....  
 Grout Intervals: From 0 ft. to 25 ft., From 80 ft. to ..... ft., From ..... ft. to ..... ft.  
 What is the nearest source of possible contamination:  
1 Septic tank 4 Lateral lines 7 Pit privy 10 Livestock pens 14 Abandoned water well  
 2 Sewer lines 5 Cess pool 8 Sewage lagoon 11 Fuel storage 15 Oil well/Gas well  
 3 Watertight sewer lines 6 Seepage pit 9 Feedyard 12 Fertilizer storage 16 Other (specify below)  
 13 Insecticide storage .....  
 Direction from well? North West How many feet? 125

FROM	TO	LITHOLOGIC LOG	FROM	TO	PLUGGING INTERVALS
0	1	Top Soil			
1	4	Brown Clay			
4	6	Yellow Shale			
6	10	Limestone			
10	25	Yellow Shale			
25	32	Limestone			
32	47	Brown Shale			
47	66	Reddish Brown Shale			
66	87	Limestone (water)			
87	120	Brown Shale			

7 CONTRACTOR'S OR LANDOWNER'S CERTIFICATION: This water well was (1) constructed, (2) reconstructed, or (3) plugged under my jurisdiction and was completed on (mo/day/year) 9/27/2000 and this record is true to the best of my knowledge and belief. Kansas Water Well Contractor's Licence No. 451 This Water Well Record was completed on (mo/day/yr) 10/9/2000 under the business name of Haldeman Well Drilling by (signature) Craig H. Cuppett