

1 LOCATION OF WATER WELL: County: Dickinson Fraction: NW 1/4 SW 1/4 SW 1/4 Section Number: 21 Township Number: T 13 S Range Number: R 3 E 10

Distance and direction from nearest town or city street address of well if located within city?


In City Enterprise 102 Lincoln

2 WATER WELL OWNER: Jack Blackman

RR#, St. Address, Box #: 102 Lincoln
City, State, ZIP Code: Enterprise, KS. 67441

Board of Agriculture, Division of Water Resources
Application Number:

3 LOCATE WELL'S LOCATION WITH AN "X" IN SECTION BOX:

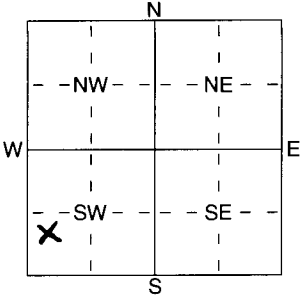

4 DEPTH OF COMPLETED WELL 70 ft. ELEVATION:

Depth(s) Groundwater Encountered 1 57 ft. 2 ft. 3 ft.
WELL'S STATIC WATER LEVEL 3.0 ft. below land surface measured on 4-27-04 mo/day/yr
Pump test data: Well water was ft. after hours pumping gpm
Est. Yield 23 gpm: Well water was ft. after hours pumping gpm
WELL WATER TO BE USED AS:
1 Domestic 2 Irrigation 3 Feedlot 4 Industrial 5 Public water supply 6 Oil field water supply 7 Domestic (lawn & garden) 8 Air conditioning 9 Dewatering 10 Monitoring well 11 Injection well 12 Other (Specify below)

Was a chemical/bacteriological sample submitted to Department? Yes No If yes, mo/day/yr sample was submitted Water Well Disinfected? Yes Yes No

5 TYPE OF BLANK CASING USED:
1 Steel 2 PVC 3 RMP (SR) 4 ABS 5 Wrought iron 6 Asbestos-Cement 7 Fiberglass 8 Concrete tile 9 Other (specify below) CASING JOINTS: Glued X Clamped Welded Threaded

Blank casing diameter 5 in. to 50 ft., Dia 50 in. to ft., Dia in. to ft.
Casing height above land surface 12 in., weight 0.1295160 lbs./ft. Wall thickness or gauge No. 214

TYPE OF SCREEN OR PERFORATION MATERIAL:
1 Steel 2 Brass 3 Stainless Steel 4 Galvanized Steel 5 Fiberglass 6 Concrete tile 7 PVC 8 RMP (SR) 9 ABS 10 Asbestos-Cement 11 Other (Specify) 12 None used (open hole)

SCREEN OR PERFORATION OPENINGS ARE:
1 Continuous slot 2 Louvered shutter 3 Mill slot 4 Key punched 5 Gauzed wrapped 6 Wire wrapped 7 Torch cut 8 Saw cut 9 Drilled holes 10 Other (specify) 11 None (open hole)

SCREEN-PERFORATED INTERVALS: From 50 ft. to 70 ft., From ft. to ft.
GRAVEL PACK INTERVALS: From 20 ft. to 70 ft., From ft. to ft.

6 GROUT MATERIAL: 1 Neat cement 2 Cement grout 3 Bentonite 4 Other
Grout Intervals: From 0 ft. to 20 ft., From ft. to ft., From ft. to ft.

What is the nearest source of possible contamination:
1 Septic tank 2 Sewer lines 3 Watertight sewer lines 4 Lateral lines 5 Cess pool 6 Seepage pit 7 Pit privy 8 Sewage lagoon 9 Feedyard 10 Livestock pens 11 Fuel storage 12 Fertilizer storage 13 Insecticide storage 14 Abandoned water well 15 Oil well/Gas well 16 Other (specify below)

Direction from well? NW How many feet? 50+

FROM	TO	LITHOLOGIC LOG	FROM	TO	PLUGGING INTERVALS
0	6	Clay			
6	10	lime			
10	24	yellow shale			
24	29	lime			
29	38	yellow shale			
38	57	yellow shale + mixed lime			
57	58	Water			
58	61	Blue shale			
61	70	Red shale			

7 CONTRACTOR'S OR LANDOWNER'S CERTIFICATION: This water well was (1) constructed, (2) reconstructed, or (3) plugged under my jurisdiction and was completed on (mo/day/year) 4-27-04 and this record is true to the best of my knowledge and belief. Kansas Water Well Contractor's Licence No 180 This Water Well Record was completed on (mo/day/yr) 4-27-04 under the business name of Boekhorst Drilling by (signature) Paul H. Boekhorst