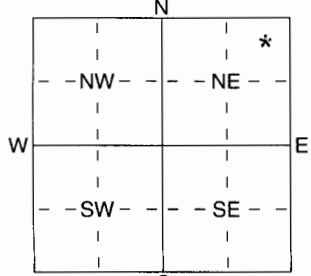


1 LOCATION OF WATER WELL: Fraction NE 1/4 NE 1/4 NE 1/4 Section Number 23 Township Number T 13 S Range Number R 3 E/W*
 County: Dickinson

Distance and direction from nearest town or city street address of well if located within city?
3 miles East of Enterprise, Ks 1 North & 1/4 East to Paint Rd & 1/8 mile South

2 WATER WELL OWNER: Larry Jäderborg
 RR#, St. Address, Box # : 1951 - 2000 Ave Board of Agriculture, Division of Water Resources
 City, State, ZIP Code : Enterprise, Kansas 67441 Application Number:

3 LOCATE WELL'S LOCATION WITH AN "X" IN SECTION BOX:

 4 DEPTH OF COMPLETED WELL 6.0 ft. ELEVATION:
 Depth(s) Groundwater Encountered 1 3.4 ft. 2 ft. 3 ft.
 WELL'S STATIC WATER LEVEL 3.1 ft. below land surface measured on mo/day/yr 8 / 24 / 04
 Pump test data: Well water was ft. after hours pumping gpm
 Est. Yield 15+ gpm: Well water was ft. after hours pumping gpm
 WELL WATER TO BE USED AS: 5 Public water supply 8 Air conditioning 11 Injection well
1 Domestic 3 Feedlot 6 Oil field water supply 9 Dewatering 12 Other (Specify below)
 2 Irrigation 4 Industrial 7 Domestic (lawn & garden) 10 Monitoring well
 Was a chemical/bacteriological sample submitted to Department? Yes No *; If yes, mo/day/yr sample was submitted
 Water Well Disinfected? Yes * No

5 TYPE OF BLANK CASING USED: 5 Wrought iron 8 Concrete tile CASING JOINTS: Glued * Clamped
 1 Steel 3 RMP (SR) 6 Asbestos-Cement 9 Other (specify below) Welded
 2 PVC 4 ABS 7 Fiberglass Threaded
 Blank casing diameter 5 in. to 6.0 ft., Dia in. to ft., Dia in. to ft.
 Casing height above land surface 14 in., weight 20.0 lbs./ft. Wall thickness or gauge No. 25.0
 TYPE OF SCREEN OR PERFORATION MATERIAL: 7 PVC 10 Asbestos-Cement
 1 Steel 3 Stainless Steel 5 Fiberglass 8 RMP (SR) 11 Other (Specify)
 2 Brass 4 Galvanized Steel 6 Concrete tile 9 ABS 12 None used (open hole)
 SCREEN OR PERFORATION OPENINGS ARE: 5 Gauzed wrapped 8 Saw cut 11 None (open hole)
 1 Continuous slot 3 Mill slot 6 Wire wrapped 9 Drilled holes
 2 Louvered shutter 4 Key punched 7 Torch cut 10 Other (specify) ft.
 SCREEN-PERFORATED INTERVALS: From 3.1 ft. to 6.0 ft., From ft. to ft.
 From ft. to ft., From ft. to ft.
 GRAVEL PACK INTERVALS: From 2.4 ft. to 6.0 ft., From ft. to ft.
 From ft. to ft., From ft. to ft.

6 GROUT MATERIAL: 1 Neat cement 2 Cement grout 3 Bentonite 4 Other
 Grout Intervals: From 2 ft. to 2.4 ft., From ft. to ft., From ft. to ft.
 What is the nearest source of possible contamination:
 1 Septic tank 4 Lateral lines 7 Pit privy 10 Livestock pens 14 Abandoned water well
 2 Sewer lines 5 Cess pool 8 Sewage lagoon 11 Fuel storage 15 Oil well/Gas well
3 Watertight sewer lines 6 Seepage pit 9 Feedyard 12 Fertilizer storage 16 Other (specify below)
 13 Insecticide storage
 Direction from well? NORTHWEST WILLBE APPROX. How many feet? 120

| FROM | TO | LITHOLOGIC LOG | FROM | TO | PLUGGING INTERVALS |
|------|----|-------------------------|------|----|--------------------|
| 0 | 1 | DARK TOP SOIL | | | |
| 1 | 5 | BROWN CLAY | | | |
| 5 | 14 | LITE COLOR LIMESTONE | | | |
| 14 | 24 | LITE COLOR CLAY | | | |
| 24 | 25 | LITE COLOR LIMESTONE | | | |
| 25 | 39 | LITE COLOR SHALE & CLAY | | | |
| 39 | 45 | RED & GRAY SHALE MIXED | | | |
| 45 | 58 | RED SHALE | | | |
| 58 | 60 | RED & TAN SHALE MIXED | | | |

RECEIVED
 SEP 17 2004
 BUREAU OF WATER

7 CONTRACTOR'S OR LANDOWNER'S CERTIFICATION: This water well was (1) constructed, (2) reconstructed, or (3) plugged under my jurisdiction and was completed on (mo/day/year) 8 / 24 / 04 and this record is true to the best of my knowledge and belief. Kansas Water Well Contractor's Licence No 397 This Water Well Record was completed on (mo/day/yr) 9 / 8 / 04 under the business name of CENTRAL KANSAS DRILLING by (signature) Arnold D. Martin