


1 LOCATION OF WATER WELL: Fraction SW 1/4 SE 1/4 SW 1/4 Section Number 24 Township Number T 13 S Range Number R 3 **EW**
 County: Dickinson

Distance and direction from nearest town or city street address of well if located within city?

2 WATER WELL OWNER: Peggy Fletcher
 RR#, St. Address, Box #: 1827 2100 Ave. Board of Agriculture, Division of Water Resources
 City, State, ZIP Code: Enterprise, Ks. 67441 Application Number:

3 LOCATE WELL'S LOCATION WITH AN "X" IN SECTION BOX:

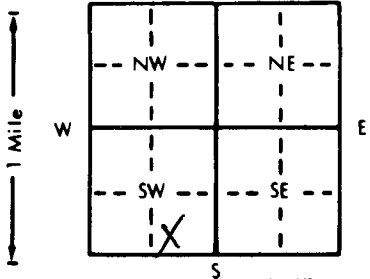

4 DEPTH OF COMPLETED WELL: 61.1 ft. ELEVATION:
 Depth(s) Groundwater Encountered 1. 23.4 ft. 2. . ft. 3. . ft.
 WELL'S STATIC WATER LEVEL: 23.4 ft. below land surface measured on mo/day/yr 8/13/98
 Pump test data: Well water was . ft. after . hours pumping . gpm
 Est. Yield . gpm: Well water was . ft. after . hours pumping . gpm
 Bore Hole Diameter . in. to . ft., and . in. to . ft.
 WELL WATER TO BE USED AS:
 1 Domestic 3 Feedlot 6 Oil field water supply 9 Dewatering 12 Other (Specify below) Decommission
 2 Irrigation 4 Industrial 7 Lawn and garden only 10 Monitoring well
 Was a chemical/bacteriological sample submitted to Department? Yes . No X; If yes, mo/day/yr sample was submitted
 Water Well Disinfected? Yes No

5 TYPE OF BLANK CASING USED:
 1 Steel 3 RMP (SR) 5 Wrought iron 8 Concrete tile CASING JOINTS: Glued . Clamped .
 2 PVC 4 ABS 6 Asbestos-Cement 9 Other (specify below) Rock Welded .
 7 Fiberglass Threaded .
 Blank casing diameter 24 in. to . ft., Dia . in. to . ft., Dia . in. to . ft.
 Casing height above land surface: 70 in., weight . lbs./ft. Wall thickness or gauge No. .
 TYPE OF SCREEN OR PERFORATION MATERIAL:
 1 Steel 3 Stainless steel 5 Fiberglass 7 PVC 10 Asbestos-cement
 2 Brass 4 Galvanized steel 6 Concrete tile 8 RMP (SR) 11 Other (specify) NA
 9 ABS 12 None used (open hole)
 SCREEN OR PERFORATION OPENINGS ARE:
 1 Continuous slot 3 Mill slot 5 Gauzed wrapped 8 Saw cut 11 None (open hole)
 2 Louvered shutter 4 Key punched 6 Wire wrapped 9 Drilled holes
 7 Torch cut 10 Other (specify) NA
 SCREEN-PERFORATED INTERVALS: From 999 ft. to 999 ft., From . ft. to . ft.
 GRAVEL PACK INTERVALS: From . ft. to . ft., From . ft. to . ft.

6 GROUT MATERIAL: 1 Neat cement 2 Cement grout 3 Bentonite 4 Other
 Grout Intervals: From 6 ft. to 4.5 ft., From . ft. to . ft., From . ft. to . ft.
 What is the nearest source of possible contamination:
 1 Septic tank 4 Lateral lines 7 Pit privy 10 Livestock pens 14 Abandoned water well
 2 Sewer lines 5 Cess pool 8 Sewage lagoon 11 Fuel storage 15 Oil well/Gas well
 3 Watertight sewer lines 6 Seepage pit 9 Feedyard 12 Fertilizer storage 16 Other (specify below) Rodents, Snakes, surface runoff
 13 Insecticide storage

Direction from well?		LITHOLOGIC LOG	PLUGGING INTERVALS	
FROM	TO		FROM	TO
<u>61.1</u>	<u>23.4</u>	<u>Washed sand</u>		
<u>23.4</u>	<u>6</u>	<u>Clay subsoil</u>		
<u>6</u>	<u>4.5</u>	<u>Bentonite</u>		
<u>4.5</u>	<u>0</u>	<u>Topsoil</u>		

7 CONTRACTOR'S OR LANDOWNER'S CERTIFICATION: This water well was (1) constructed, (2) reconstructed, or (3) plugged under my jurisdiction and was completed on (mo/day/year) 8/13/98 and this record is true to the best of my knowledge and belief. Kansas Water Well Contractor's License No. . This Water Well Record was completed on (mo/day/yr) 8-13-98 under the business name of . by (signature) Peggy J. Fletcher