


1 LOCATION OF WATER WELL: County: Dickinson Fraction NE 1/4 NE 1/4 NE 1/4 Section Number 1 Township Number T 13 S Range Number R 3 E

Distance and direction from nearest town or city street address of well if located within city? 1 mile West of Chapman, Ks on Hwy 40 & 1 mile South

2 WATER WELL OWNER: Lester Deines RR#, St. Address, Box #: 716 W 4 City, State, ZIP Code: Chapman, Kansas 67431 Board of Agriculture, Division of Water Resources Application Number:

3 LOCATE WELL'S LOCATION WITH AN "X" IN SECTION BOX:

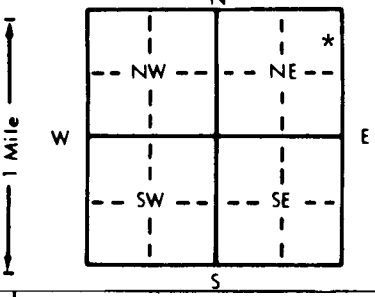

4 DEPTH OF COMPLETED WELL: 4.1 ft. ELEVATION: Depth(s) Groundwater Encountered 1. 29.6 ft. 2. ft. 3. ft. WELL'S STATIC WATER LEVEL 29.6 ft. below land surface measured on mo/day/yr 3 / 15 / 95 Pump test data: Well water was ft. after hours pumping gpm Est. Yield 1.5+ gpm: Well water was ft. after hours pumping gpm Bore Hole Diameter 9 in. to 4.1 ft., and in. to ft. WELL WATER TO BE USED AS: 5 Public water supply 8 Air conditioning 11 Injection well 1 Domestic 3 Feedlot 6 Oil field water supply 9 Dewatering 12 Other (Specify below) 2 Irrigation 4 Industrial 7 Lawn and garden only 10 Monitoring well Was a chemical/bacteriological sample submitted to Department? Yes * No; If yes, mo/day/yr sample was submitted Water Well Disinfected? Yes * No

5 TYPE OF BLANK CASING USED: 1 Steel 3 RMP (SR) 5 Wrought iron 8 Concrete tile CASING JOINTS: Glued * Clamped Welded Threaded 2 PVC 4 ABS 6 Asbestos-Cement 9 Other (specify below) Blank casing diameter 5 in. to 4.1 ft., Dia in. to ft., Dia in. to ft. Casing height above land surface 22 in., weight 160 lbs./ft. Wall thickness or gauge No. 214

TYPE OF SCREEN OR PERFORATION MATERIAL: 1 Steel 3 Stainless steel 5 Fiberglass 7 PVC 10 Asbestos-cement 2 Brass 4 Galvanized steel 6 Concrete tile 8 RMP (SR) 11 Other (specify) 12 None used (open hole)

SCREEN OR PERFORATION OPENINGS ARE: 1 Continuous slot 3 Mill slot 5 Gauzed wrapped 8 Saw cut 11 None (open hole) 2 Louvered shutter 4 Key punched 6 Wire wrapped 9 Drilled holes 7 Torch cut 10 Other (specify)

SCREEN-PERFORATED INTERVALS: From 37 ft. to 41 ft., From ft. to ft. From ft. to ft. From ft. to ft. GRAVEL PACK INTERVALS: From 24 ft. to 41 ft., From ft. to ft. From ft. to ft. From ft. to ft.

6 GROUT MATERIAL: 1 Neat cement 2 Cement grout 3 Bentonite 4 Other Grout intervals: From 0 ft. to 24 ft., From ft. to ft., From ft. to ft.

What is the nearest source of possible contamination: 1 Septic tank 4 Lateral lines 7 Pit privy 10 Livestock pens 14 Abandoned water well 2 Sewer lines 5 Cess pool 8 Sewage lagoon 11 Fuel storage 15 Oil well/Gas well 3 Watertight sewer lines 6 Seepage pit 9 Feedyard 12 Fertilizer storage 16 Other (specify below) 13 Insecticide storage Direction from well? SOUTHEAST APPROX How many feet? 1200

Table with columns: FROM, TO, LITHOLOGIC LOG, FROM, TO, PLUGGING INTERVALS. Data rows: 0-3 DARK TOP SOIL, 3-23 BROWN CLAY, 23-41 SAND.

7 CONTRACTOR'S OR LANDOWNER'S CERTIFICATION: This water well was (1) constructed, (2) reconstructed, or (3) plugged under my jurisdiction and was completed on (mo/day/year) 3 / 15 / 95 and this record is true to the best of my knowledge and belief. Kansas Water Well Contractor's License No. 297 This Water Well Record was completed on (mo/day/yr) 3 / 26 / 95 under the business name of CENTRAL KANSAS DRILLING by (signature) Harold O. Martin

INSTRUCTIONS: Use typewriter or ball point pen. PLEASE PRESS FIRMLY and PRINT clearly. Please fill in blanks, underline or circle the correct answers. Send top three copies to Kansas Department of Health and Environment, Bureau of Water, Topeka, Kansas 66620-0001. Telephone: 913-296-5545. Send one to WATER WELL OWNER and retain one for your records.

008167