


1 LOCATION OF WATER WELL: County: Dickinson Fraction NW 1/4 NW 1/4 NE 1/4 Section Number 8 Township Number T 13 S Range Number R 4 E/W

Distance and direction from nearest town or city street address of well if located within city?
2 miles South of Chapman, Ks & 1/2 mile East

2 WATER WELL OWNER: Viola Bemiss
 RR#, St. Address, Box #: 2054 2400 Ave. Board of Agriculture, Division of Water Resources
 City, State, ZIP Code: Chapman, Kansas 67431 Application Number:

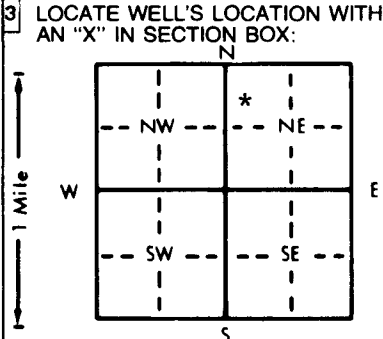

4 DEPTH OF COMPLETED WELL: 113 ft. ELEVATION: ft.
 Depth(s) Groundwater Encountered 1. 86 ft. 2. ft. 3. ft.
 WELL'S STATIC WATER LEVEL 79 ft. below land surface measured on mo/day/yr 8 / 24 / 96
 Pump test data: Well water was ft. after hours pumping gpm
 Est. Yield 15 gpm: Well water was ft. after hours pumping gpm
 Bore Hole Diameter 9 in. to 113 ft., and in. to ft.
 WELL WATER TO BE USED AS:
1 Domestic 3 Feedlot 6 Oil field water supply 9 Dewatering 12 Other (Specify below)
 2 Irrigation 4 Industrial 7 Lawn and garden only 10 Monitoring well
 Was a chemical/bacteriological sample submitted to Department? Yes.....No.....; If yes, mo/day/yr sample was submitted
 Water Well Disinfected? Yes * No

5 TYPE OF BLANK CASING USED:
 1 Steel 3 RMP (SR) 5 Wrought iron 8 Concrete tile CASING JOINTS: Glued * Clamped
 2 PVC 4 ABS 6 Asbestos-Cement 9 Other (specify below) Welded
 7 Fiberglass Threaded.....
 Blank casing diameter 5 in. to 113 ft., Dia. in. to ft., Dia. in. to ft.
 Casing height above land surface 17 in., weight 160 lbs./ft. Wall thickness or gauge No. 214
 TYPE OF SCREEN OR PERFORATION MATERIAL:
 1 Steel 3 Stainless steel 5 Fiberglass 7 PVC 10 Asbestos-cement
 2 Brass 4 Galvanized steel 6 Concrete tile 9 ABS 12 None used (open hole)
 SCREEN OR PERFORATION OPENINGS ARE:
 1 Continuous slot 3 Mill slot 5 Gauzed wrapped 8 Saw cut 11 None (open hole)
 2 Louvered shutter 4 Key punched 6 Wire wrapped 9 Drilled holes
 7 Torch cut 10 Other (specify)
 SCREEN-PERFORATED INTERVALS: From 82 ft. to 113 ft., From ft. to ft.
 From ft. to ft., From ft. to ft.
 GRAVEL PACK INTERVALS: From 28 ft. to 113 ft., From ft. to ft.
 From ft. to ft., From ft. to ft.

6 GROUT MATERIAL: 1 Neat cement 2 Cement grout 3 Bentonite 4 Other
 Grout Intervals: From 3 ft. to 28 ft., From ft. to ft., From ft. to ft.
 What is the nearest source of possible contamination:
 1 Septic tank 4 Lateral lines 7 Pit privy 10 Livestock pens 14 Abandoned water well
 2 Sewer lines 5 Cess pool 8 Sewage lagoon 11 Fuel storage 15 Oil well/Gas well
 3 Watertight sewer lines 6 Seepage pit 9 Feedyard 12 Fertilizer storage 16 Other (specify below)
 13 Insecticide storage
 Direction from well? NORTH APPROX How many feet? 100

| FROM | TO | LITHOLOGIC LOG | FROM | TO | PLUGGING INTERVALS |
|------|-----|-----------------------------------|------|----|--------------------|
| 0 | 6 | DARK TOP SOIL | | | |
| 6 | 9 | LITE COLOR LIMESTONE | | | |
| 9 | 19 | LITE COLOR SHALE | | | |
| 19 | 23 | LITE COLOR LIMESTONE & FLINT ROCK | DARK | | |
| 23 | 34 | LITE COLOR SHALE | | | |
| 34 | 48 | RED SHALE | | | |
| 48 | 61 | LITE COLOR SHALE & CLAY | | | |
| 61 | 74 | LITE COLOR LIMESTONE | | | |
| 74 | 82 | LITE COLOR SHALE | | | |
| 82 | 86 | LITE COLOR LIMESTONE | | | |
| 86 | 91 | LITE GRAY SHALE | | | |
| 91 | 99 | LITE COLOR LIMESTONE | | | |
| 99 | 100 | GRAY SHALE | | | |
| 100 | 107 | HARD GRAY LIMESTONE | | | |
| 107 | 113 | GRAY SHALE | | | |

7 CONTRACTOR'S OR LANDOWNER'S CERTIFICATION: This water well was (1) constructed, (2) reconstructed, or (3) plugged under my jurisdiction and was completed on (mo/day/year) 8 / 24 / 96 and this record is true to the best of my knowledge and belief. Kansas Water Well Contractor's License No. 397 This Water Well Record was completed on (mo/day/yr) 8 / 29 / 96 under the business name of CENTRAL KANSAS DRILLING by (signature) Sawold D. Martin

INSTRUCTIONS: Use typewriter or ball point pen. PLEASE PRESS FIRMLY and PRINT clearly. Please fill in blanks, underline or circle the correct answers. Send top three copies to Kansas Department of Health and Environment, Bureau of Water, Topeka, Kansas 66620-0001. Telephone: 913-296-5545. Send one to WATER WELL OWNER and retain one for your records.