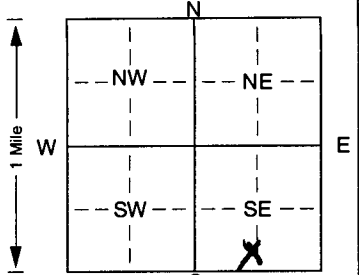


1 LOCATION OF WATER WELL: Fraction Se 1/4 Sw 1/4 Sec 12 Section Number 12 Township Number T 13 S Range Number R 40 EA
 County: Dickinson

Distance and direction from nearest town or city street address of well if located within city?
4 3/4 E 2 3/4 S Chapman

2 WATER WELL OWNER: Walter Teetzen
 RR#, St. Address, Box #: 2475 2300 Ave Board of Agriculture, Division of Water Resources
 City, State, ZIP Code: Junction City, KS. 66441 Application Number:

3 LOCATE WELL'S LOCATION WITH AN "X" IN SECTION BOX:

 4 DEPTH OF COMPLETED WELL: 110 ft. ELEVATION:
 Depth(s) Groundwater Encountered 1. 95 ft. 2. ft. 3. ft.
 WELL'S STATIC WATER LEVEL . . . 50 ft. below land surface measured on mo/day/yr 8-29-02
 Pump test data: Well water was ft. after hours pumping gpm
 Est. Yield 1.0 gpm Well water was ft. after hours pumping gpm
 Bore Hole Diameter. . . 4 1/2 in. to 110 ft., and in. to ft.
 WELL WATER TO BE USED AS: 5 Public water supply 8 Air conditioning 11 Injection well
 1 Domestic 3 Feedlot 6 Oil field water supply 9 Dewatering 12 Other (Specify below)
 2 Irrigation 4 Industrial 7 Domestic (lawn & garden) 10 Monitoring well
 Was a chemical/bacteriological sample submitted to Department? Yes. No. X; If yes, mo/day/yr sample was submitted
 Water Well Disinfected? Yes X No

5 TYPE OF BLANK CASING USED:
 1 Steel 3 RMP (SR) 5 Wrought iron 8 Concrete tile CASING JOINTS: Glued. X Clamped.
 2 PVC 4 ABS 6 Asbestos-Cement 9 Other (specify below) Welded
 7 Fiberglass Threaded
 Blank casing diameter . . . 5 in. to 70 ft., Dia in. to ft., Dia in. to ft.
 Casing height above land surface. . . 12 in., weight Clas 99 160 lbs./ft. Wall thickness or gauge No. 214

TYPE OF SCREEN OR PERFORATION MATERIAL:
 1 Steel 3 Stainless steel 5 Fiberglass 7 PVC 10 Asbestos-cement
 2 Brass 4 Galvanized steel 6 Concrete tile 8 RMP (SR) 11 Other (specify)
 9 ABS 12 None used (open hole)
 SCREEN OR PERFORATION OPENINGS ARE:
 1 Continuous slot 3 Mill slot 5 Gauzed wrapped 8 Saw cut 11 None (open hole)
 2 Louvered shutter 4 Key punched 6 Wire wrapped 9 Drilled holes
 7 Torch cut 10 Other (specify) ft.
 SCREEN-PERFORATED INTERVALS: From. . . 70 ft. to 110 ft., From ft. to ft.
 From ft. to ft., From ft. to ft.
 GRAVEL PACK INTERVALS: From. . . 20 ft. to 110 ft., From ft. to ft.
 From ft. to ft., From ft. to ft.

6 GROUT MATERIAL: 1 Neat cement 2 Cement grout 3 Bentonite 4 Other
 Grout Intervals: From. . . 0 ft. to 20 ft., From ft. to ft., From ft. to ft.
 What is the nearest source of possible contamination:
 1 Septic tank 4 Lateral lines 7 Pit privy 10 Livestock pens 14 Abandoned water well
 2 Sewer lines 5 Cess pool 8 Sewage lagoon 11 Fuel storage 15 Oil well/Gas well
 3 Watertight sewer lines 6 Seepage pit 9 Feedyard 12 Fertilizer storage 16 Other (specify below)
 13 Insecticide storage
 Direction from well? NE How many feet? 100 +

FROM	TO	LITHOLOGIC LOG	FROM	TO	PLUGGING INTERVALS
<u>0</u>	<u>2</u>	<u>Clay</u>			
<u>2</u>	<u>12</u>	<u>Lime</u>			
<u>12</u>	<u>24</u>	<u>Clay</u>			
<u>24</u>	<u>40</u>	<u>Lime</u>			
<u>40</u>	<u>95</u>	<u>Gray Shale Hard</u>			
<u>95</u>	<u>97</u>	<u>Broken Shale & Water</u>			
<u>97</u>	<u>110</u>	<u>Gray Shale</u>			

7 CONTRACTOR'S OR LANDOWNER'S CERTIFICATION: This water well was (1) constructed, (2) reconstructed, or (3) plugged under my jurisdiction and was completed on (mo/day/year) 8-29-02 and this record is true to the best of my knowledge and belief. Kansas Water Well Contractor's Licence No. 120 This Water Well Record was completed on (mo/day/yr) 8-2-02 under the business name of Beckhus Drilling by (signature) Paul H. Beckhus