


1 LOCATION OF WATER WELL: Fraction SW 1/4 SW 1/4 SW 1/4 Section Number 13 Township Number T 13 S Range Number R 4 E/W
 County: Dickinson

Distance and direction from nearest town or city street address of well if located within city? From J.C. & I 70 Go 4 miles south on 77 to Lyons Creek Rd. Turn west & go 4 miles to Billi & Thin Co North West 3 miles

2 WATER WELL OWNER: Cliff Hutchinson
 RR#, St. Address, Box #: RR Board of Agriculture, Division of Water Resources
 City, State, ZIP Code: Junction City, KS 66441 Application Number:

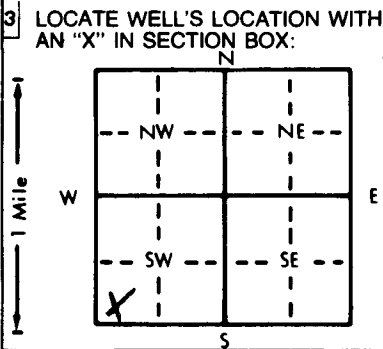

4 DEPTH OF COMPLETED WELL: 140 ft. ELEVATION: ft.
 Depth(s) Groundwater Encountered 1. 10.5 ft. 2. ft. 3. ft.
 WELL'S STATIC WATER LEVEL: 9.5 ft. below land surface measured on mo/day/yr ft.
 Pump test data: Well water was ft. after hours pumping gpm
 Est. Yield 9 gpm: Well water was ft. after hours pumping gpm
 Bore Hole Diameter: 9 in. to 140 ft., and in. to ft.
 WELL WATER TO BE USED AS:
 1 Domestic 3 Feedlot 6 Oil field water supply 9 Dewatering 12 Other (Specify below)
 2 Irrigation 4 Industrial 7 Lawn and garden only 10 Monitoring well
 Was a chemical/bacteriological sample submitted to Department? Yes..... No.....; If yes, mo/day/yr sample was submitted
 Water Well Disinfected? Yes No

5 TYPE OF BLANK CASING USED:
 1 Steel 3 RMP (SR) 5 Wrought iron 8 Concrete tile CASING JOINTS: Glued Clamped
 2 PVC 4 ABS 6 Asbestos-Cement 9 Other (specify below) Welded
 Blank casing diameter 5 in. to 120 ft., Dia in. to ft., Dia in. to ft.
 Casing height above land surface 2 in., weight 5400 lbs./ft. Wall thickness or gauge No.
 TYPE OF SCREEN OR PERFORATION MATERIAL:
 1 Steel 3 Stainless steel 5 Fiberglass 7 PVC 10 Asbestos-cement
 2 Brass 4 Galvanized steel 6 Concrete tile 8 RMP (SR) 11 Other (specify)
 12 None used (open hole)
 SCREEN OR PERFORATION OPENINGS ARE:
 1 Continuous slot 3 Mill slot 25/1000 5 Gauzed wrapped 8 Saw cut 11 None (open hole)
 2 Louvered shutter 4 Key punched 120 6 Wire wrapped 9 Drilled holes
 7 Torch cut 140 10 Other (specify)
 SCREEN-PERFORATED INTERVALS: From ft. to ft., From ft. to ft.
 GRAVEL PACK INTERVALS: From 25 ft. to 140 ft., From ft. to ft.

6 GROUT MATERIAL: 1 Neat cement 2 Cement grout 3 Bentonite 4 Other
 Grout intervals: From 0 ft. to 25 ft., From ft. to ft.
 What is the nearest source of possible contamination: None Close
 1 Septic tank 4 Lateral lines 7 Pit privy 10 Livestock pens 14 Abandoned water well
 2 Sewer lines 5 Cess pool 8 Sewage lagoon 11 Fuel storage 15 Oil well/Gas well
 3 Watertight sewer lines 6 Seepage pit 9 Feedyard 12 Fertilizer storage 16 Other (specify below)
 Direction from well? How many feet?

FROM	TO	LITHOLOGIC LOG	FROM	TO	PLUGGING INTERVALS
0	1	Top Soil	123	131	Brown Shale
1	2	Brown Clay	131	134	Limestone
2	5	Limestone	134	135	Grey Shale
5	15	yellow shale	135	140	Limestone & Flint
15	17	Limestone			
17	23	Greenish Shale			
23	32	yellow shale			
32	56	Brown Shale			
56	69	Limestone			
69	74	Brown Shale			
74	85	yellow shale			
85	103	Brown Shale			
103	107	Limestone (Water)			
107	116	Grey Shale			
116	123	Limestone			

7 CONTRACTOR'S OR LANDOWNER'S CERTIFICATION: This water well was (1) constructed, (2) reconstructed, or (3) plugged under my jurisdiction and was completed on (mo/day/year) 4/24/95 and this record is true to the best of my knowledge and belief. Kansas Water Well Contractor's License No. 451 This Water Well Record was completed on (mo/day/yr) 5/11/95 under the business name of Holdeman Well Drilling by (signature) Cliff Hutchinson