


1 LOCATION OF WATER WELL: County: GEARY Fraction: NE 1/4 NE 1/4 NE 1/4 Section Number: 2 Township Number: T 13S S Range Number: R X 5E E/W

Distance and direction from nearest town or city street address of well if located within city?
3 south of Junction City

2 WATER WELL OWNER: Craig Woods
 RR#, St. Address, Box # : 3110 Old Stage Road
 City, State, ZIP Code : Junction City, KS 66441
 Board of Agriculture, Division of Water Resources
 Application Number:

3 LOCATE WELL'S LOCATION WITH AN "X" IN SECTION BOX:

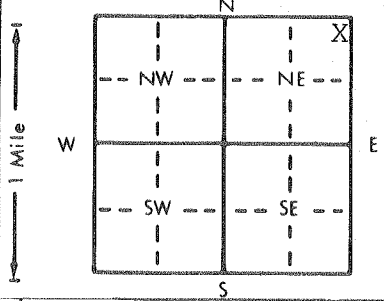

4 DEPTH OF COMPLETED WELL: 60' ft. ELEVATION: ft.
 Depth(s) Groundwater Encountered 1. 50' ft. 2. ft. 3. ft.
 WELL'S STATIC WATER LEVEL 42' ft. below land surface measured on mo/day/yr 9-25-95
 Pump test data: Well water was ft. after hours pumping gpm
 Est. Yield 35 gpm: Well water was ft. after hours pumping gpm
 Bore Hole Diameter 8 3/4 in. to ft., and in. to ft.
 WELL WATER TO BE USED AS:
 5 Public water supply 8 Air conditioning 11 Injection well
 1 Domestic 3 Feedlot 6 Oil field water supply 9 Dewatering 12 Other (Specify below)
 2 Irrigation 4 Industrial 7 Lawn and garden only 10 Monitoring well
 Was a chemical/bacteriological sample submitted to Department? Yes.....No.....X.....; If yes, mo/day/yr sample was submitted
 Water Well Disinfected? Yes X No

5 TYPE OF BLANK CASING USED:
 1 Steel 3 RMP (SR) 5 Wrought iron 8 Concrete tile CASING JOINTS: Glued X Clamped
 2 PVC 4 ABS 6 Asbestos-Cement 9 Other (specify below) Welded
 7 Fiberglass Threaded.....

Blank casing diameter 5" in. to 0-21 ft., Dia 5" in. to 24-40 ft., Dia in. to ft.
 Casing height above land surface 24" in., weight 2.82 lbs./ft. Wall thickness or gauge No. .258

TYPE OF SCREEN OR PERFORATION MATERIAL:
 1 Steel 3 Stainless steel 5 Fiberglass 7 PVC 10 Asbestos-cement
 2 Brass 4 Galvanized steel 6 Concrete tile 8 RMP (SR) 11 Other (specify)
 9 ABS 12 None used (open hole)

SCREEN OR PERFORATION OPENINGS ARE:
 1 Continuous slot 3 Mill slot 5 Gauzed wrapped 8 Saw cut 11 None (open hole)
 2 Louvered shutter 4 Key punched 6 Wire wrapped 9 Drilled holes
 7 Torch cut 10 Other (specify)

SCREEN-PERFORATED INTERVALS: From 21 ft. to 24 ft., From ft. to ft.
 From 40 ft. to 60 ft., From ft. to ft.
 GRAVEL PACK INTERVALS: From 20 ft. to 60 ft., From ft. to ft.
 From ft. to ft., From ft. to ft.

6 GROUT MATERIAL: 1 Neat cement 2 Cement grout 3 Bentonite 4 Other
 Grout Intervals: From 0 ft. to 20 ft., From ft. to ft., From ft. to ft.

What is the nearest source of possible contamination:
 1 Septic tank 4 Lateral lines 7 Pit privy 10 Livestock pens 14 Abandoned water well
 2 Sewer lines 5 Cess pool 8 Sewage lagoon 11 Fuel storage 15 Oil well/Gas well
 3 Watertight sewer lines 6 Seepage pit 9 Feedyard 12 Fertilizer storage 16 Other (specify below)
 13 Insecticide storage

Direction from well? west How many feet? 400'

FROM	TO	LITHOLOGIC LOG	FROM	TO	PLUGGING INTERVALS
0	2	Top Soil	37	41	Grey Shale
2	10	Brown Clay	41	43	Grey Limestone
10	16	Brown Clay Sandy	43	47	Tan Limestone
16	17	Limestone-Chert	47	48	Grey Limestone
17	20	Grey Shale	48	50	Tan Limestone-hard
20	21	Grey Limestone	50	53	Tan Limestone soft-water
21	22	Br Limestone-Loose (1 GPM)	53	54	Tan Limestone-hard
22	23	Tan Limestone	54	55	Grey Limestone-hard
23	24	Grey Shale	55	57	Tan Limestone-loose
24	27	Grey Limestone-Flinty	57	58	Grey Limestone-hard
27	30	Grey Shale	58	59	Tan Limestone
30	31	Grey Limestone	59	60	Grey Shale
31	32	Grey Shale			
32	34	Grey Shale-Limestone			
34	37	Grey Limestone w/ Gyp soft			

7 CONTRACTOR'S OR LANDOWNER'S CERTIFICATION: This water well was (1) constructed, (2) reconstructed, or (3) plugged under my jurisdiction and was completed on (mo/day/year) 9-25-95 and this record is true to the best of my knowledge and belief. Kansas Water Well Contractor's License No. 182 This Water Well Record was completed on (mo/day/yr) 11-9-95 under the business name of STRADER DRILLING CO., INC. by (signature) [Signature]