


1 LOCATION OF WATER WELL: Fraction  $\frac{1}{4}$  NC  $\frac{1}{4}$  NW  $\frac{1}{4}$  Section Number 3 Township Number T 13 S Range Number R 5 EW  
 County: Geary

Distance and direction from nearest town or city street address of well if located within city? 1 mile west on 18 to 0m Junction City  
To 77 6 miles south on 47 to Lyons Creek Road + go 1/2 mile west

2 WATER WELL OWNER: Mr. Dial B Leach 1-238-7927  
 RR#, St. Address, Box #: 1410 Rucker Circle  
 City, State, ZIP Code: Junction City, Kansas Board of Agriculture, Division of Water Resources Application Number:

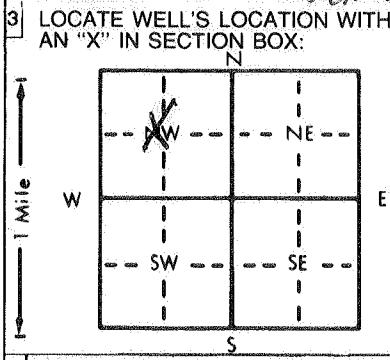

4 DEPTH OF COMPLETED WELL: 53' ft. ELEVATION: .....  
 Depth(s) Groundwater Encountered 1. 28' ft. 2. .... ft. 3. .... ft.  
 WELL'S STATIC WATER LEVEL: 21' ft. below land surface measured on mo/day/yr .....  
 Pump test data: Well water was ..... ft. after ..... hours pumping ..... gpm  
 Est. Yield: 60 gpm; Well water was ..... ft. after ..... hours pumping ..... gpm  
 Bore Hole Diameter: 10 in. to 20' ft., and 8" in. to 53' ft.  
 WELL WATER TO BE USED AS:  
 1 Domestic  3 Feedlot  6 Oil field water supply  9 Dewatering  12 Other (Specify below)  
 2 Irrigation  4 Industrial  7 Lawn and garden only  10 Observation well  
 Was a chemical/bacteriological sample submitted to Department? Yes.....No.....X..... If yes, mo/day/yr sample was submitted  
 Water Well Disinfected? Yes X No

5 TYPE OF BLANK CASING USED:  
 1 Steel  3 RMP (SR)  5 Wrought iron  8 Concrete tile CASING JOINTS: Glued Clamped  
 2 PVC  4 ABS  6 Asbestos-Cement  9 Other (specify below) Welded Seamless  
 7 Fiberglass  11 Injection well  
 12 Other (Specify below)  
 Blank casing diameter: 5" in. to 33' ft., Dia. .... in. to .... ft., Dia. .... in. to .... ft.  
 Casing height above land surface: 2' in., weight Sch 40 lbs./ft. Wall thickness or gauge No. ....

TYPE OF SCREEN OR PERFORATION MATERIAL:  
 1 Steel  3 Stainless steel  5 Fiberglass  7 PVC  10 Asbestos-cement  
 2 Brass  4 Galvanized steel  6 Concrete tile  8 RMP (SR)  11 Other (specify) .....  
 12 None used (open hole)

SCREEN OR PERFORATION OPENINGS ARE:  
 1 Continuous slot  3 Mill slot 31/1000s  5 Gauzed wrapped  8 Saw cut  11 None (open hole)  
 2 Louvered shutter  4 Key punched  6 Wire wrapped  9 Drilled holes  
 7 Torch cut  10 Other (specify) .....

SCREEN-PERFORATED INTERVALS: From 33 ft. to 53 ft., From ..... ft. to ..... ft.  
 From ..... ft. to ..... ft., From ..... ft. to ..... ft.  
 GRAVEL PACK INTERVALS: From 25 ft. to 53 ft., From ..... ft. to ..... ft.  
 From ..... ft. to ..... ft., From ..... ft. to ..... ft.

6 GROUT MATERIAL:  1 Neat cement  2 Cement grout  3 Bentonite  4 Other  
 Grout Intervals: From 5' ft. to 25' ft., From ..... ft. to ..... ft., From ..... ft. to ..... ft.  
 What is the nearest source of possible contamination: None close  
 1 Septic tank  4 Lateral lines  7 Pit privy  10 Livestock pens  14 Abandoned water well  
 2 Sewer lines  5 Cess pool  8 Sewage lagoon  11 Fuel storage  15 Oil well/Gas well  
 3 Watertight sewer lines  6 Seepage pit  9 Feedyard  12 Fertilizer storage  16 Other (specify below)  
 13 Insecticide storage

Direction from well? How many feet?

FROM	TO	LITHOLOGIC LOG	FROM	TO	LITHOLOGIC LOG
0	13	Brown clay			
13	17	Rock			
17	19	Shale			
19	23	Rock			
23	28	Shale			
28	38	Rock (water)			
38	35	Shale			
35	36	Shale			
36	53'	Rock			

7 CONTRACTOR'S OR LANDOWNER'S CERTIFICATION: This water well was (1) constructed, (2) reconstructed, or (3) plugged under my jurisdiction and was completed on (mo/day/year) 4/24/81 and this record is true to the best of my knowledge and belief. Kansas Water Well Contractor's License No. 451 This Water Well Record was completed on (mo/day/yr) 5/19/81 under the business name of Haldeman Well Drilling by (signature) [Signature]