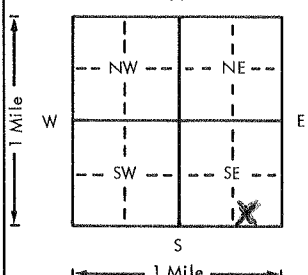


Sent 12-21-76

USE TYPEWRITER OR BALL POINT PEN-PRESS FIRMLY, PRINT CLEARLY.

WATER WELL RECORD
KSA 82a-1201-1215

Kansas Department of Health and Environment-Division of Environment (Water well Contractors) Topeka, Kansas 66620

1. Location of well: County <u>Geary</u> Fraction <u>SW 1/4 Sec 14 E 1/4</u> Section number <u>28</u> Township number <u>T 13 S R 5 E/W</u> Range number																												
2. Distance and direction from nearest town or city: <u>11 S 1 W</u> Street address of well location if in city: <u>Junction City</u>																												
3. Owner of well: <u>Shirley Janke</u> R.R. or street: <u>RR 2</u> City, state, zip code: <u>Junction City, Ks.</u>																												
4. Locate with "X" in section below: Sketch map: 																												
5. Type and color of material																												
<table border="1"> <thead> <tr> <th></th> <th>From</th> <th>To</th> </tr> </thead> <tbody> <tr> <td>Top Soil</td> <td>0</td> <td>1</td> </tr> <tr> <td>Yellow Clay</td> <td>1</td> <td>15</td> </tr> <tr> <td>Red + Yellow Shale</td> <td>15</td> <td>35</td> </tr> <tr> <td>Lime Stone</td> <td>35</td> <td>65</td> </tr> <tr> <td>Gray Rock</td> <td>65</td> <td>94</td> </tr> <tr> <td>Lime Stone</td> <td>94</td> <td>110</td> </tr> <tr> <td>Water</td> <td>110</td> <td>112</td> </tr> <tr> <td>Gray Rock</td> <td>112</td> <td>120</td> </tr>
6. Bore hole dia <u>2-7</u> in. Completion date <u>12-1-76</u> Well depth <u>120</u> ft.																												
7. <input checked="" type="checkbox"/> Cable tool <input type="checkbox"/> Rotary <input type="checkbox"/> Driven <input type="checkbox"/> Dug <input type="checkbox"/> Hollow rod <input type="checkbox"/> Jetted <input type="checkbox"/> Bored <input type="checkbox"/> Reverse rotary																												
8. Use: <input checked="" type="checkbox"/> Domestic <input type="checkbox"/> Public supply <input type="checkbox"/> Industry <input type="checkbox"/> Irrigation <input type="checkbox"/> Air conditioning <input type="checkbox"/> Stock <input type="checkbox"/> Lawn <input type="checkbox"/> Oil field water <input type="checkbox"/> Other																												
9. Casing: Material <u>PVC</u> Height: Above or below Threading <input type="checkbox"/> Welded <input type="checkbox"/> Surface <u>75</u> in. RMP <input type="checkbox"/> PVC <input checked="" type="checkbox"/> Weight <u>8.4</u> lbs./ft. Dia. <u>5</u> in. to <u> </u> ft. depth Wall Thickness: inches or Dia. <u> </u> in. to <u> </u> ft. depth gage No. <u>258</u>																												
10. Screen: Manufacturer's name <u>Certain Tech</u> Type <u>PVC</u> Dia. <u>5</u> Slot/gauge <u>5</u> Length <u>20</u> in. Set between <u>100</u> ft. and <u>120</u> ft. Gravel pack? <input checked="" type="checkbox"/> Size range of material <u>1/4 - 3/8</u> in.																												
11. Static water level: <u>110</u> ft. below land surface Date <u>MISC</u> mo./day/yr.																												
12. Pumping level below land surfaces: <u> </u> ft. after <u> </u> hrs. pumping <u> </u> g.p.m. <u> </u> ft. after <u> </u> hrs. pumping <u> </u> g.p.m. Estimated maximum yield <u> </u> g.p.m.																												
13. Water sample submitted: <input checked="" type="checkbox"/> Yes <input type="checkbox"/> No Date <u> </u> mo./day/yr.																												
14. Well head completion: <input checked="" type="checkbox"/> Pitless adapter <u> </u> inches above grade																												
15. Well grouted? <input checked="" type="checkbox"/> With: <input type="checkbox"/> Neat cement <input type="checkbox"/> Bentonite <input checked="" type="checkbox"/> Concrete Depth: From <u>3</u> ft. to <u>13</u> ft.																												
16. Nearest source of possible contamination: <u>SEPTIC</u> ft. <u>110</u> Direction <u>NE</u> Type <u>TANK</u> Well disinfected upon completion? <input checked="" type="checkbox"/> Yes <input type="checkbox"/> No																												
17. Pump: <input checked="" type="checkbox"/> Not installed Manufacturer's name <u> </u> Model number <u> </u> HP <u> </u> Volts <u> </u> Length of drop pipe <u> </u> ft. capacity <u> </u> g.p.m. Type: <input type="checkbox"/> Submersible <input type="checkbox"/> Turbine <input type="checkbox"/> Jet <input type="checkbox"/> Reciprocating <input type="checkbox"/> Centrifugal <input type="checkbox"/> Other																												
18. Elevation: Topography: <input checked="" type="checkbox"/> Hill <input type="checkbox"/> Slope <input type="checkbox"/> Upland <input type="checkbox"/> Valley																												
19. Remarks: (Use a second sheet if needed)																												
20. Water well contractor's certification: This well was drilled under my jurisdiction and this report is true to the best of my knowledge and belief. Business name <u>Backhaus Drilling</u> License No. <u>180</u> Address <u> </u> Signed <u> </u> Date <u>12-1-76</u> Authorized representative																												

T 13 S R 5 E/W Sec 14 E 1/4

Forward the white, blue and pink copies to the Department of Health and Environment

Form WWC-5