


1 LOCATION OF WATER WELL: Fraction NW 1/4 SE 1/4 SW 1/4 Section Number 28 Township Number T 13 S Range Number R 5 EW
 County: GEARY
 Distance and direction from nearest town or city street address of well if located within city? 9 1/2 MILES SOUTH OF JUNCTION CITY ON TT # 134 WEST ON 157

2 WATER WELL OWNER: STEVE RUNNKE
 RR#, St. Address, Box #: RR1 BOX 59A
 City, State, ZIP Code: JUNCTION CITY KS 66644
 Board of Agriculture, Division of Water Resources
 Application Number:

3 LOCATE WELL'S LOCATION WITH AN "X" IN SECTION BOX:

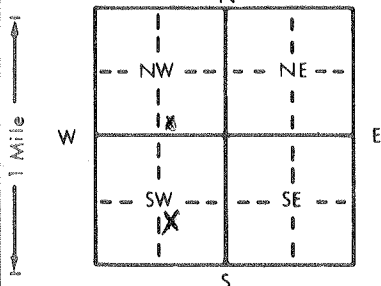

4 DEPTH OF COMPLETED WELL: 140 ft. ELEVATION:
 Depth(s) Groundwater Encountered 1. 111 ft. 2. ft. 3. ft.
 WELL'S STATIC WATER LEVEL 90 ft. below land surface measured on mo/day/yr
 Pump test data: Well water was ft. after hours pumping gpm
 Est. Yield 12 gpm: Well water was ft. after hours pumping gpm
 Bore Hole Diameter 9 in. to 140 ft., and in. to ft.
 WELL WATER TO BE USED AS: 5 Public water supply 8 Air conditioning 11 Injection well
 Domestic 3 Feedlot 6 Oil field water supply 9 Dewatering 12 Other (Specify below)
 2 Irrigation 4 Industrial 7 Lawn and garden only 10 Monitoring well
 Was a chemical/bacteriological sample submitted to Department? Yes.....No.....; If yes, mo/day/yr sample was submitted

5 TYPE OF CASING USED:
 1 Steel 3 RMP (SR) 5 Wrought iron 8 Concrete tile CASING JOINTS: Glued Screwed
 PVC 4 ABS 7 Fiberglass 9 Other (specify below) Welded
 Blank casing diameter 5 in. to 120 ft., Dia. in. to ft., Dia. in. to ft.
 Casing height above land surface 2 in., weight SCH 40 lbs./ft. Wall thickness or gauge No.

TYPE OF SCREEN OR PERFORATION MATERIAL:
 1 Steel 3 Stainless steel 5 Fiberglass 8 RMP (SR) 10 Asbestos-cement
 2 Brass 4 Galvanized steel 6 Concrete tile 9 ABS 11 Other (specify)
 SCREEN OR PERFORATION OPENINGS ARE:
 1 Continuous slot 3 Mill slot 3/1000 5 Gauzed wrapped 8 Saw cut 11 None (open hole)
 2 Louvered shutter 4 Key punched 6 Wire wrapped 9 Drilled holes
 7 Torch cut 10 Other (specify)

SCREEN-PERFORATED INTERVALS: From 120 ft. to 140 ft., From ft. to ft.
 GRAVEL PACK INTERVALS: From 20 ft. to 140 ft., From ft. to ft.
 From ft. to ft., From ft. to ft.

6 GROUT MATERIAL: 1 Neat cement 2 Cement grout Bentonite 4 Other
 Grout Intervals: From 0 ft. to 20 ft., From ft. to ft., From ft. to ft.
 What is the nearest source of possible contamination:
 1 Septic tank 4 Lateral lines 7 Pit privy 10 Livestock pens 14 Abandoned water well
 2 Sewer lines 5 Cess pool 8 Sewage lagoon 11 Fuel storage 15 Oil well/Gas well
 3 Watertight sewer lines 6 Seepage pit 9 Feedyard 12 Fertilizer storage 16 Other (specify below)
 13 Insecticide storage
 Direction from well? NONE CLOSE How many feet?

FROM	TO	LITHOLOGIC LOG	FROM	TO	PLUGGING INTERVALS
0	1	TOP SOIL	92	94	GRAY SHALE
1	17	GREENISH SHALE	94	96	LIME STONE
17	39	BROWN SHALE	96	111	BROWN SHALE
39	45	LIME STONE	111	113	LIME STONE
45	47	BROWN SHALE	113	114	BROWN SHALE
47	48	LIME STONE	114	138	FLINT ROCK
48	53	YELLOW SHALE	138	140	GRAY SHALE
53	57	GREENISH SHALE			
57	58	LIME STONE			
58	64	BROWN SHALE			
64	67	LIME STONE			
67	68	BROWN SHALE			
68	81	LIME STONE			
81	83	YELLOW SHALE			
83	92	LIME STONE			

7 CONTRACTOR'S OR LANDOWNER'S CERTIFICATION: This water well was constructed, reconstructed, or plugged under my jurisdiction and was completed on (mo/day/year) 10/3/90 and this record is true to the best of my knowledge and belief. Kansas Water Well Contractor's License No. 451 This Water Well Record was completed on (mo/day/yr) 10/22/90 under the business name of HALDEMAN WELL DRILLING by (signature) [Signature]