


1 LOCATION OF WATER WELL: County: OSAGE Fraction: SW 1/4 SE 1/4 SW 1/4 Section Number: 20 Township Number: T 13 S Range Number: R 5 E

Distance and direction from nearest town or city street address of well if located within city?  
3 MILES WEST & 7 SOUTH OF JUNCTION CITY.

2 WATER WELL OWNER: WARREN LEMNER  
 RR#, St. Address, Box #: 14815 W. LYON CREEK RD Board of Agriculture, Division of Water Resources  
 City, State, ZIP Code: JUNCTION CITY, KS. 66441 Application Number: \_\_\_\_\_

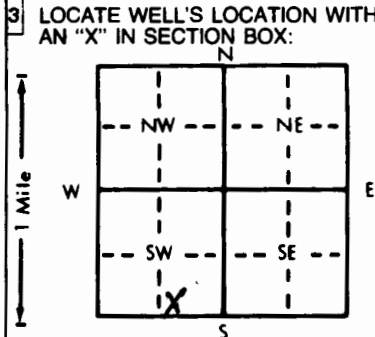

4 DEPTH OF COMPLETED WELL: 82 ft. ELEVATION: \_\_\_\_\_  
 Depth(s) Groundwater Encountered 1. 30 ft. 2. \_\_\_\_\_ ft. 3. \_\_\_\_\_ ft.  
 WELL'S STATIC WATER LEVEL: 24 ft. below land surface measured on mo/day/yr 12/13/98  
 Pump test data: Well water was \_\_\_\_\_ ft. after \_\_\_\_\_ hours pumping \_\_\_\_\_ gpm  
 Est. Yield 6-7 gpm: Well water was \_\_\_\_\_ ft. after \_\_\_\_\_ hours pumping \_\_\_\_\_ gpm  
 Bore Hole Diameter: 8.625 in. to 82 ft., and \_\_\_\_\_ in. to \_\_\_\_\_ ft.  
 WELL WATER TO BE USED AS:  
 1 Domestic  2 Irrigation  3 Feedlot  4 Industrial   
 5 Public water supply  6 Oil field water supply  7 Lawn and garden only   
 8 Air conditioning  9 Dewatering  10 Monitoring well   
 11 Injection well  12 Other (Specify below) \_\_\_\_\_  
 Was a chemical/bacteriological sample submitted to Department? Yes \_\_\_\_\_ No X; If yes, mo/day/yr sample was submitted \_\_\_\_\_  
 Water Well Disinfected? Yes X No \_\_\_\_\_

5 TYPE OF BLANK CASING USED:  
 1 Steel  2 PVC  3 RMP (SR)  4 ABS   
 5 Wrought iron  6 Asbestos-Cement  7 Fiberglass   
 8 Concrete tile  9 Other (specify below) \_\_\_\_\_  
 CASING JOINTS: Glued X Clamped \_\_\_\_\_  
 Welded \_\_\_\_\_ Threaded \_\_\_\_\_  
 Blank casing diameter: 5 in. to 62 ft., Dia. \_\_\_\_\_ in. to \_\_\_\_\_ ft., Dia. \_\_\_\_\_ in. to \_\_\_\_\_ ft.  
 Casing height above land surface: 18 in., weight \_\_\_\_\_ lbs./ft. Wall thickness or gauge No. SOP 26  
 TYPE OF SCREEN OR PERFORATION MATERIAL:  
 1 Steel  2 Brass  3 Stainless steel  4 Galvanized steel   
 5 Fiberglass  6 Concrete tile  7 PVC  8 RMP (SR)   
 10 Asbestos-cement  11 Other (specify) \_\_\_\_\_  
 12 None used (open hole) \_\_\_\_\_  
 SCREEN OR PERFORATION OPENINGS ARE:  
 1 Continuous slot  2 Louvered shutter  3 Mill slot  4 Key punched   
 5 Gauzed wrapped  6 Wire wrapped  7 Torch cut   
 8 Saw cut  9 Drilled holes  10 Other (specify) \_\_\_\_\_  
 11 None (open hole) \_\_\_\_\_  
 SCREEN-PERFORATED INTERVALS: From 62 ft. to 82 ft., From \_\_\_\_\_ ft. to \_\_\_\_\_ ft.  
 From \_\_\_\_\_ ft. to \_\_\_\_\_ ft., From \_\_\_\_\_ ft. to \_\_\_\_\_ ft.  
 GRAVEL PACK INTERVALS: From 23 ft. to 82 ft., From \_\_\_\_\_ ft. to \_\_\_\_\_ ft.  
 From \_\_\_\_\_ ft. to \_\_\_\_\_ ft., From \_\_\_\_\_ ft. to \_\_\_\_\_ ft.

6 GROUT MATERIAL: 1 Neat cement  2 Cement grout  3 Bentonite  4 Other \_\_\_\_\_  
 Grout Intervals: From 0 ft. to 23 ft., From \_\_\_\_\_ ft. to \_\_\_\_\_ ft., From \_\_\_\_\_ ft. to \_\_\_\_\_ ft.  
 What is the nearest source of possible contamination:  
 1 Septic tank  2 Sewer lines  3 Watertight sewer lines   
 4 Lateral lines  5 Cess pool  6 Seepage pit   
 7 Pit privy  8 Sewage lagoon  9 Feedyard   
 10 Livestock pens  11 Fuel storage  12 Fertilizer storage   
 13 Insecticide storage  14 Abandoned water well  15 Oil well/Gas well   
 16 Other (specify below) \_\_\_\_\_  
 Direction from well? 50 FEET How many feet? SOUTH

FROM	TO	LITHOLOGIC LOG	FROM	TO	PLUGGING INTERVALS
0	3	SOIL			
3	12	CHERTY LIMASTONE			
12	25	SHALE, GREEN GRAY			
25	32	LIMASTONE, YELLOW			
32	56	SHALE GRAY			
56	68	MUDSTONE GRAY			
68	73	LIMASTONE GRAY			
73	82	SHALE, GRAY			
	82	TD			

7 CONTRACTOR'S OR LANDOWNER'S CERTIFICATION: This water well was (1) constructed, (2) reconstructed, or (3) plugged under my jurisdiction and was completed on (mo/day/year) 12/13/98 and this record is true to the best of my knowledge and belief. Kansas Water Well Contractor's License No. 505 This Water Well Record was completed on (mo/day/yr) 12/14/98 under the business name of ABE by (signature) \_\_\_\_\_

OFFICE USE ONLY  
T  
R  
E/W  
SEC.  
1/4  
1/4  
1/4