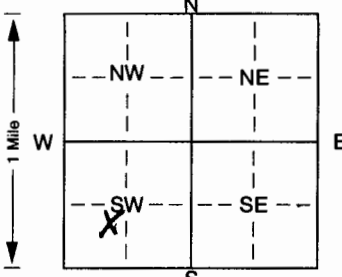


1 LOCATION OF WATER WELL: Fraction NE 1/4 SW 1/4 SW 1/4 Section Number 20 Township Number T 13 S Range Number R 5 (EWN)  
 County: GOODY

Distance and direction from nearest town or city street address of well if located within city?  
I-70 & HWY 77 INTERSECTION, BUMPLES SOUTH, 3 MILES WEST, 1 1/2 MILES NORTH

2 WATER WELL OWNER: PHIL JANKOWICZ  
 RR#, St. Address, Box # : \_\_\_\_\_  
 City, State, ZIP Code : JUNCTION CITY KS  
 Board of Agriculture, Division of Water Resources  
 Application Number: \_\_\_\_\_

3 LOCATE WELL'S LOCATION WITH AN "X" IN SECTION BOX:  
  
 4 DEPTH OF COMPLETED WELL: 63 ft. ELEVATION: \_\_\_\_\_  
 Depth(s) Groundwater Encountered 1. 25 ft. 2. \_\_\_\_\_ ft. 3. \_\_\_\_\_ ft.  
 WELL'S STATIC WATER LEVEL: 15 ft. below land surface measured on mo/day/yr 4/15/01  
 Pump test data: Well water was \_\_\_\_\_ ft. after \_\_\_\_\_ hours pumping \_\_\_\_\_ gpm  
 Est. Yield 4 gpm: Well water was \_\_\_\_\_ ft. after \_\_\_\_\_ hours pumping \_\_\_\_\_ gpm  
 Bore Hole Diameter: 8.75 in. to 6.3 in. to \_\_\_\_\_ ft.  
 WELL WATER TO BE USED AS:  
 1 Domestic  3 Feedlot  6 Oil field water supply  9 Dewatering  11 Injection well  
 2 Irrigation  4 Industrial  7 Domestic (lawn & garden)  10 Monitoring well  
 Was a chemical/bacteriological sample submitted to Department? Yes. \_\_\_\_\_ No. X; If yes, mo/day/yrs sample was submitted \_\_\_\_\_  
 Water Well Disinfected? Yes X No \_\_\_\_\_

5 TYPE OF BLANK CASING USED:  
 1 Steel  3 RMP (SR)  5 Wrought iron  8 Concrete tile  CASING JOINTS: X Glued  Clamped  
 2 PVC  4 ABS  6 Asbestos-Cement  9 Other (specify below)  Welded  
 7 Fiberglass  Threaded  
 Blank casing diameter 5 in. to 4.3 ft., Dia \_\_\_\_\_ in. to \_\_\_\_\_ ft., Dia \_\_\_\_\_ in. to \_\_\_\_\_ ft.  
 Casing height above land surface: 24 in., weight \_\_\_\_\_ lbs./ft. Wall thickness or gauge No. SUR 26  
 TYPE OF SCREEN OR PERFORATION MATERIAL:  
 1 Steel  3 Stainless steel  5 Fiberglass  7 PVC  10 Asbestos-cement  
 2 Brass  4 Galvanized steel  6 Concrete tile  8 RMP (SR)  11 Other (specify) \_\_\_\_\_  
 9 ABS  12 None used (open hole)  
 SCREEN OR PERFORATION OPENINGS ARE:  
 1 Continuous slot  3 Mill slot  5 Gauzed wrapped  8 Saw cut  11 None (open hole)  
 2 Louvered shutter  4 Key punched  6 Wire wrapped  9 Drilled holes  
 7 Torch cut  10 Other (specify) \_\_\_\_\_ ft.  
 SCREEN-PERFORATED INTERVALS: From 43 ft. to 63 ft., From \_\_\_\_\_ ft. to \_\_\_\_\_ ft.  
 From \_\_\_\_\_ ft. to \_\_\_\_\_ ft., From \_\_\_\_\_ ft. to \_\_\_\_\_ ft.  
 GRAVEL PACK INTERVALS: From 20 ft. to 63 ft., From \_\_\_\_\_ ft. to \_\_\_\_\_ ft.  
 From \_\_\_\_\_ ft. to \_\_\_\_\_ ft., From \_\_\_\_\_ ft. to \_\_\_\_\_ ft.

6 GROUT MATERIAL:  1 Neat cement  2 Cement grout  3 Bentonite  4 Other \_\_\_\_\_  
 Grout Intervals: From 0 ft. to 20 ft., From \_\_\_\_\_ ft. to \_\_\_\_\_ ft., From \_\_\_\_\_ ft. to \_\_\_\_\_ ft.  
 What is the nearest source of possible contamination:  
 1 Septic tank  4 Lateral lines  7 Pit privy  10 Livestock pens  14 Abandoned water well  
 2 Sewer lines  5 Cess pool  8 Sewage lagoon  11 Fuel storage  15 Oil well/Gas well  
 3 Watertight sewer lines  6 Seepage pit  9 Feedyard  12 Fertilizer storage  16 Other (specify below) \_\_\_\_\_  
 13 Insecticide storage \_\_\_\_\_  
 Direction from well? EAST  
 How many feet? 50

FROM	TO	LITHOLOGIC LOG	FROM	TO	PLUGGING INTERVALS
0	24	CLAY			
24	25	GRAVEL			
25	31	LIMESTONE			
31	36	SANDY CLAY			
36	38	LIMESTONE			
38	49	SANDY BROWN			
49	51	LIMESTONE			
51	53	SANDY GRAY			
53	57	CHERTY, LIMESTONE			
57	63	SANDY			
	63	TOTAL DEPTH			

7 CONTRACTOR'S OR LANDOWNER'S CERTIFICATION: This water well was (1) constructed, (2) reconstructed, or (3) plugged under my jurisdiction and was completed on (mo/day/year) 4/15/01 and this record is true to the best of my knowledge and belief. Kansas Water Well Contractor's Licence No. 585 This Water Well Record was completed on (mo/day/yr) 5/15/01 under the business name of ASSOCIATED ENVIRONMENTAL INC by (signature) [Signature]