

County: Geary Fraction NE NE NE SW Sec. 4 T 13 S R 5 (E)W

CORRECTION(S) TO WATER WELL COMPLETION RECORD (WWC-5)

(to rectify lacking or incorrect information)

Owner: Darlyne Westberg

Location was listed as:

Section-Township-Range: 4 - 13 S - 5 E

Fraction (1/4 1/4 1/4): NE NE SE

Location changed to:

4 - 13 S - 5 E

NE NE NE SW

Other changes: Initial statements: _____

Changed to: _____

Comments: _____

Verification method: Written description, area road map, and mapping tool & aerial photos on KGS website.

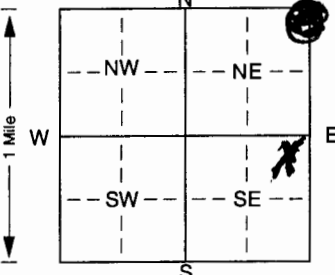
initials: DRJ date: 1/29/2013

Submitted by: Kansas Geological Survey, Data Resources Library, 1930 Constant Ave., Lawrence, KS 66047-3726

to: Kansas Dept of Health & Environment, Bureau of Water, 1000 SW Jackson, Suite 420, Topeka, KS 66612-1367.

1 LOCATION OF WATER WELL: Fraction NE 1/4 NE 1/4 SE 1/4 Section Number 4 Township Number T 13 S Range Number R 5 E
 County: GRAVY
 Distance and direction from nearest town or city street address of well if located within city? N 8 miles south of Junction City well located N. 200 south of Poland Road at the corner of Poland and Beck Road.

2 WATER WELL OWNER: Darlene Westberg
 RR#, St. Address, Box #: 8720 Beck Road Board of Agriculture, Division of Water Resources
 City, State, ZIP Code: Junction City, KS, 66441 Application Number:

3 LOCATE WELL'S LOCATION WITH AN "X" IN SECTION BOX:  DEPTH OF COMPLETED WELL: 140 ft. ELEVATION: ft.
 Depth(s) Groundwater Encountered 65 ft. 2. ft. 3. ft.
 WELL'S STATIC WATER LEVEL 65 ft. below land surface measured on mo/day/yr
 Pump test data: Well water was ft. after hours pumping gpm
 Est. Yield 1/2 gpm: Well water was ft. after hours pumping gpm
 Bore Hole Diameter: 9 in. to 140 ft., and in. to ft.
 WELL WATER TO BE USED AS: 5 Public water supply 8 Air conditioning 11 Injection well
1 Domestic 3 Feedlot 6 Oil field water supply 9 Dewatering 12 Other (Specify below)
 2 Irrigation 4 Industrial 7 Domestic (lawn & garden) 10 Monitoring well
 Was a chemical/bacteriological sample submitted to Department? Yes. No.; If yes, mo/day/yr sample was submitted
 Water Well Disinfected? Yes No

5 TYPE OF BLANK CASING USED: 5 Wrought iron 8 Concrete tile CASING JOINTS: Glued Clamped
 1 Steel 3 RMP (SR) 6 Asbestos-Cement 9 Other (specify below) Welded
2 PVC 4 ABS 7 Fiberglass Threaded
 Blank casing diameter 5 in. to 120 ft., Dia. in. to ft., Dia. in. to ft.
 Casing height above land surface: 2 in., weight Sch. 40 lbs./ft. Wall thickness or gauge No.
 TYPE OF SCREEN OR PERFORATION MATERIAL: TPVC 10 Asbestos-cement
 1 Steel 3 Stainless steel 5 Fiberglass 8 RMP (SR) 11 Other (specify)
 2 Brass 4 Galvanized steel 6 Concrete tile 9 ABS 12 None used (open hole)
 SCREEN OR PERFORATION OPENINGS ARE: 5 Gauzed wrapped 8 Saw cut 11 None (open hole)
 1 Continuous slot 3 Mill slot 6 Wire wrapped 9 Drilled holes
 2 Louvered shutter 4 Key punched 7 Torch cut 10 Other (specify) ft.
 SCREEN-PERFORATED INTERVALS: From 120 ft. to 140 ft., From ft. to ft.
 From ft. to ft., From ft. to ft.
 GRAVEL PACK INTERVALS: From 25 ft. to 140 ft., From ft. to ft.
 From ft. to ft., From ft. to ft.

6 GROUT MATERIAL: 1 Neat cement 2 Cement grout 3 Bentonite 4 Other
 Grout Intervals: From 0 ft. to 25 ft., From ft. to ft., From ft. to ft.
 What is the nearest source of possible contamination: 10 Livestock pens 14 Abandoned water well
 1 Septic tank 4 Lateral lines 7 Pit privy 11 Fuel storage 15 Oil well/Gas well
 2 Sewer lines 5 Cess pool 8 Sewage lagoon 12 Fertilizer storage 16 Other (specify below)
 3 Watertight sewer lines 6 Seepage pit 9 Feedyard 13 Insecticide storage
 Direction from well? South How many feet? 125

FROM	TO	LITHOLOGIC LOG	FROM	TO	PLUGGING INTERVALS
0	1/2	Top soil			
1/2	2	Limestone			
2	6	yellow shale			
6	21	Greenish Shale			
21	23	Limestone			
23	31	Greenish Shale			
31	65	Gray Shale			
65	96	Limestone			
96	114	Brown shale			
114	122	Limestone			
122	130	Gray Shale			
130	140	Limestone			

7 CONTRACTOR'S OR LANDOWNER'S CERTIFICATION: This water well was (1) constructed, (2) reconstructed, or (3) plugged under my jurisdiction and was completed on (mo/day/year) 5/2002 and this record is true to the best of my knowledge and belief. Kansas Water Well Contractor's Licence No. 451 This Water Well Record was completed on (mo/day/yr) 6/3/2002 under the business name of Haldeman Well Drilling by (signature) [Signature]