


LOCATION OF WATER WELL: Fraction SW 1/4 SW 1/4 SW 1/4 Section Number 6 Township Number T 13 S Range Number 60 E/W  
 County: Geary  
 Distance and direction from nearest town or city street address of well if located within city?  
1 1/2 mile West, S North 1/2 West Skiddy

WATER WELL OWNER: LENN TAYLOR  
 RR#, St. Address, Box #: ARI Board of Agriculture, Division of Water Resources  
 City, State, ZIP Code: Sumner City KS Application Number:

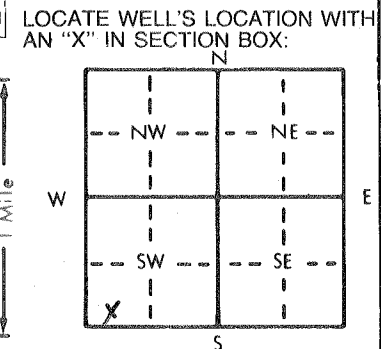

DEPTH OF COMPLETED WELL: 77 ft. ELEVATION:  
 Depth(s) Groundwater Encountered 1. 67 ft. 2. ft. 3. ft.  
 WELL'S STATIC WATER LEVEL 45 ft. below land surface measured on mo/day/yr Mar 22 83  
 Pump test data: Well water was ft. after hours pumping gpm  
 Est. Yield 25 gpm Well water was ft. after hours pumping gpm  
 Bore Hole Diameter 8 in. to 77 ft., and in. to ft.  
 WELL WATER TO BE USED AS:  
 1 Domestic  3 Feedlot  6 Oil field water supply  9 Dewatering  12 Other (Specify below)  
 2 Irrigation  4 Industrial  7 Lawn and garden only  10 Observation well  
 Was a chemical/bacteriological sample submitted to Department? Yes  No  If yes, mo/day/yr sample was submitted  
 Water Well Disinfected?  Yes  No

TYPE OF BLANK CASING USED:  
 1 Steel  3 RMP (SR)  5 Wrought iron  8 Concrete tile CASING JOINTS:  Glued  Clamped  
 2 PVC  4 ABS  6 Asbestos-Cement  9 Other (specify below)  Welded  
 7 Fiberglass  Threaded  
 Blank casing diameter 5 in. to 45 ft., Dia in. to ft., Dia in. to ft.  
 Casing height above land surface 18 in., weight lbs./ft. Wall thickness or gauge No. 1241

TYPE OF SCREEN OR PERFORATION MATERIAL:  
 1 Steel  3 Stainless steel  5 Fiberglass  7 PVC  10 Asbestos-cement  
 2 Brass  4 Galvanized steel  6 Concrete tile  9 ABS  11 Other (specify)  
 12 None used (open hole)

SCREEN OR PERFORATION OPENINGS ARE:  
 1 Continuous slot  3 Mill slot  5 Gauzed wrapped  8 Saw cut  11 None (open hole)  
 2 Louvered shutter  4 Key punched  6 Wire wrapped  9 Drilled holes  
 7 Torch cut  10 Other (specify)

SCREEN-PERFORATED INTERVALS: From 45 ft. to 77 ft., From ft. to ft., From ft. to ft.  
 GRAVEL PACK INTERVALS: From NONE ft. to ft., From ft. to ft., From ft. to ft.

GROUT MATERIAL:  1 Neat cement  2 Cement grout  3 Bentonite  4 Other  
 Grout Intervals: From 3 ft. to 13 ft., From ft. to ft., From ft. to ft.

What is the nearest source of possible contamination:  
 1 Septic tank  4 Lateral lines  7 Pit privy  10 Livestock pens  14 Abandoned water well  
 2 Sewer lines  5 Cess pool  8 Sewage lagoon  11 Fuel storage  15 Oil well/Gas well  
 3 Watertight sewer lines  6 Seepage pit  9 Feedyard  12 Fertilizer storage  16 Other (specify below)  
 13 Insecticide storage  
 Direction from well? SW Down hill How many feet? 150

FROM	TO	LITHOLOGIC LOG	FROM	TO	LITHOLOGIC LOG
0	1	Top soil	01		
1	9	Clay Bw	01		
9	21	LIME Yel	20		
21	28	Shale Green	19		
28	41	LIME Wht Hard	20		
41	44	LIME Yel Soft	20		
44	48	LIME Yel Hard	20		
48	67	LIME - Blue Gray Solid	20		
67	70	CREVICE	20		
70	77	LIME	20		

CONTRACTOR'S OR LANDOWNER'S CERTIFICATION: This water well was (1) constructed, (2) reconstructed, or (3) plugged under my jurisdiction and was completed on (mo/day/year) Mar 22 83 and this record is true to the best of my knowledge and belief. Kansas Water Well Contractor's License No. 218 This Water Well Record was completed on (mo/day/yr) Mar 26 - 83 under the business name of Zinn Water Well Dring by (signature) Joseph A. Zinn

INSTRUCTIONS: Use typewriter or ball point pen, PLEASE PRESS FIRMLY and PRINT clearly. Please fill in blanks, underline or circle the correct answers. Send to three copies to Kansas Department of Health and Environment, Division of Environment, Environmental Geology Section, Topeka, KS 66620. Send one to WATER WELL OWNER and retain one for your records.