

1 LOCATION OF WATER WELL  
 County: Gearry Fraction NE  $\frac{1}{4}$  SE  $\frac{1}{4}$  SW  $\frac{1}{4}$  Section Number 20 Township Number T 13 S Range Number R 6 **EW**

Distance and direction from nearest town or city? 3 miles west and 7 miles north of White City Street address of well if located within city?

2 WATER WELL OWNER: Don Palmer  
 RR#, St. Address, Box #: Box 253 Board of Agriculture, Division of Water Resources  
 City, State, ZIP Code: White City, Kans. Application Number:

3 DEPTH OF COMPLETED WELL: 51 ft. Bore Hole Diameter: 9 in. to . . . . . ft., and . . . . . in. to . . . . . ft.  
 Well Water to be used as:  
 1 Domestic 1 3 Feedlot 6 Oil field water supply 8 Air conditioning 11 Injection well  
 2 Irrigation 4 Industrial 7 Lawn and garden only 9 Dewatering 12 Other (Specify below)  
 Well's static water level: 25 ft. below land surface measured on January month 13 day 1981 year  
 Pump Test Data: Well water was . . . . . ft. after . . . . . hours pumping. . . . . gpm  
 Est. Yield 4 gpm: Well water was . . . . . ft. after . . . . . hours pumping . . . . . gpm


4 TYPE OF BLANK CASING USED:  
 1 Steel 3 RMP (SR) 5 Wrought iron 8 Concrete tile Casing Joints: Glued . . . . . Clamped . . . . .  
 2 PVC 4 ABS 6 Asbestos-Cement 9 Other (specify below) SDR 26 . . . . . Welded . . . . .  
 7 Fiberglass . . . . . Threaded . . . . .  
 Blank casing dia: 5 in. to 32 ft., Dia . . . . . in. to . . . . . ft., Dia . . . . . in. to . . . . . ft.  
 Casing height above land surface: 24 in., weight 200 lbs./ft. Wall thickness or gauge No. 0.258

TYPE OF SCREEN OR PERFORATION MATERIAL:  
 1 Steel 3 Stainless steel 5 Fiberglass 7 PVC 10 Asbestos-cement  
 2 Brass 4 Galvanized steel 6 Concrete tile 8 RMP (SR) 11 Other (specify) SDR 26 . . . . .  
 9 ABS 12 None used (open hole)  
 Screen or Perforation Openings Are:  
 1 Continuous slot 3 Mill slot 5 Gauzed wrapped 8 Saw cut 11 None (open hole)  
 2 Louvered shutter 4 Key punched 6 Wire wrapped 9 Drilled holes  
 7 Torch cut 10 Other (specify) . . . . .  
 Screen-Perforation Dia: 5 in. to . . . . . ft., Dia . . . . . in. to . . . . . ft., Dia . . . . . in. to . . . . . ft.  
 Screen-Perforated Intervals: From 32 ft. to 51 ft., From . . . . . ft. to . . . . . ft.  
 From . . . . . ft. to . . . . . ft., From . . . . . ft. to . . . . . ft.  
 Gravel Pack Intervals: From 13 ft. to 51 ft., From . . . . . ft. to . . . . . ft.  
 From . . . . . ft. to . . . . . ft., From . . . . . ft. to . . . . . ft.

5 GROUT MATERIAL: 1 Neat cement 2 Cement grout 3 Bentonite 4 Other . . . . .  
 Grouted Intervals: From 3 ft. to 13 ft., From . . . . . ft. to . . . . . ft., From . . . . . ft. to . . . . . ft.

What is the nearest source of possible contamination:  
 1 Septic tank 4 Cess pool 7 Sewage lagoon 10 Fuel storage 14 Abandoned water well  
 2 Sewer lines 5 Seepage pit 8 Feed yard 11 Fertilizer storage 15 Oil well/Gas well  
 3 Lateral lines 6 Pit privy 9 Livestock pens 12 Insecticide storage 16 Other (specify below)  
 13 Watertight sewer lines  
 Direction from well: south How many feet: 1400' ? Water Well Disinfected? Yes . . . . . No . . . . .  
 Was a chemical/bacteriological sample submitted to Department? Yes . . . . . No . . . . . If yes, date sample  
 was submitted . . . . . month . . . . . day . . . . . year: Pump Installed? Yes . . . . . No . . . . .  
 If Yes: Pump Manufacturer's name . . . . . Model No. . . . . HP . . . . . Volts . . . . .  
 Depth of Pump Intake . . . . . ft. Pumps Capacity rated at . . . . . gal./min.  
 Type of pump: 1 Submersible 2 Turbine 3 Jet 4 Centrifugal 5 Reciprocating 6 Other

6 CONTRACTOR'S OR LANDOWNER'S CERTIFICATION: This water well was (1) constructed, (2) reconstructed, or (3) plugged under my jurisdiction and was  
 completed on January month 13 day 1981 year  
 and this record is true to the best of my knowledge and belief. Kansas Water Well Contractor's License No. 397  
 This Water Well Record was completed on January month 31 day 1981 year under the business  
 name of CENTRAL KANSAS DRILLING by (signature) Harold D. Martin

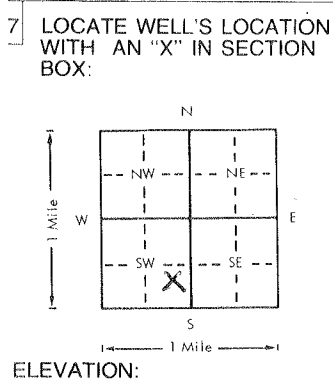

FROM	TO	LITHOLOGIC LOG	FROM	TO	LITHOLOGIC LOG
0	4	Black top soil			
4	35	Brown clay			
35	37	Limestone			
37	39	Gravel			
39	41	Blue clay			
41	46	Gray shale			
46	50	Hard dark limestone			
50	51	Flint			

Depth(s) Groundwater Encountered 1.37 ft. 2. . . . . ft. 3. . . . . ft. 4. . . . . ft. (Use a second sheet if needed)

INSTRUCTIONS: Use typewriter or ball point pen, please press firmly and PRINT clearly. Please fill in blanks, underline or circle the correct answers. Send top three copies to Kansas Department of Health and Environment, Division of Environment, Water Well Contractors, Topeka, KS 66620. Send one to WATER WELL OWNER and retain one for your records.