


1 LOCATION OF WATER WELL: County: Geary Fraction: SW 1/4 SW 1/4 SW 1/4 Section Number: 35 Township Number: T 13 S Range Number: R 6 E

Distance and direction from nearest town or city street address of well if located within city? From White City Co 5 miles North on County Road From Train Depot Then to 1/4 mile then pasture

2 WATER WELL OWNER: Less Nelson  
 RR#, St. Address, Box #: RR #1, Box 85  
 City, State, ZIP Code: White City, Kansas 66872  
 Board of Agriculture, Division of Water Resources  
 Application Number:

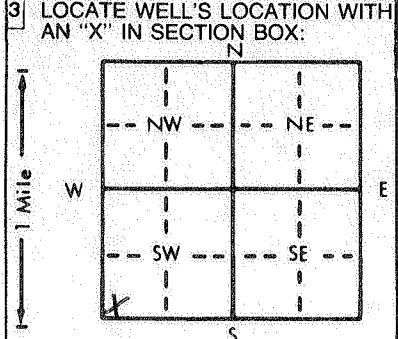

4 DEPTH OF COMPLETED WELL: 50' ft. ELEVATION:  
 Depth(s) Groundwater Encountered 1. 23' ft. 2. ft. 3. ft.  
 WELL'S STATIC WATER LEVEL: 22' ft. below land surface measured on mo/day/yr  
 Pump test data: Well water was ft. after hours pumping gpm  
 Est. Yield: 10 gpm Well water was ft. after hours pumping gpm  
 Bore Hole Diameter: 8 in. to 50' ft., and in. to ft.  
 WELL WATER TO BE USED AS:  
 1 Domestic  3 Feedlot  6 Oil field water supply  9 Dewatering  12 Other (Specify below)  
 2 Irrigation  4 Industrial  7 Lawn and garden only  10 Monitoring well  
 Was a chemical/bacteriological sample submitted to Department? Yes.....No..... If yes, mo/day/yr sample was submitted

5 TYPE OF BLANK CASING USED:  
 1 Steel  3 RMP (SR)  5 Wrought iron  8 Concrete tile CASING JOINTS:  Glued  x  Screwed  Clamped  
 2 PVC  4 ABS  6 Asbestos-Cement  9 Other (specify below)  Welded  
 7 Fiberglass  Threaded

Blank casing diameter: 5" in. to 30 ft., Dia. in. to ft., Dia. in. to ft.  
 Casing height above land surface: 2' in., weight Sch 40 lbs./ft. Wall thickness or gauge No.

TYPE OF SCREEN OR PERFORATION MATERIAL:  
 1 Steel  3 Stainless steel  5 Fiberglass  7 PVC  10 Asbestos-cement  
 2 Brass  4 Galvanized steel  6 Concrete tile  8 RMP (SR)  11 Other (specify)  
 12 None used (open hole)

SCREEN OR PERFORATION OPENINGS ARE:  
 1 Continuous slot  3 Mill slot 31/1000's  5 Gauzed wrapped  8 Saw cut  11 None (open hole)  
 2 Louvered shutter  4 Key punched  6 Wire wrapped  9 Drilled holes  
 7 Torch cut  10 Other (specify)

SCREEN-PERFORATED INTERVALS: From 30 ft. to 50 ft., From ft. to ft.  
 From ft. to ft., From ft. to ft., From ft. to ft.  
 GRAVEL PACK INTERVALS: From 20 ft. to 50 ft., From ft. to ft.  
 From ft. to ft., From ft. to ft.

6 GROUT MATERIAL:  1 Neat cement  2 Cement grout  3 Bentonite  4 Other  
 Grout Intervals: From 0 ft. to 20 ft., From ft. to Enviro plug ft., From ft. to ft.

What is the nearest source of possible contamination: None Close  
 1 Septic tank  4 Lateral lines  7 Pit privy  10 Livestock pens  14 Abandoned water well  
 2 Sewer lines  5 Cess pool  8 Sewage lagoon  11 Fuel storage  15 Oil well/Gas well  
 3 Watertight sewer lines  6 Seepage pit  9 Feedyard  12 Fertilizer storage  16 Other (specify below)  
 13 Insecticide storage

Direction from well? How many feet?

FROM	TO	LITHOLOGIC LOG	FROM	TO	PLUGGING INTERVALS
0	4	Brown Clay			
4	8	Rock			
8	10	Grey shale			
10	14	Rock			
14	23	Grey shale			
23	34	<del>Brown shale</del> Rock (Water)			
34	36	Brown shale			
36	39	ROCK			
39	50	Grey shale			

7 CONTRACTOR'S OR LANDOWNER'S CERTIFICATION: This water well was  (1) constructed,  (2) reconstructed, or  (3) plugged under my jurisdiction and was completed on (mo/day/year) 11/30/88 and this record is true to the best of my knowledge and belief. Kansas Water Well Contractor's License No. 451 This Water Well Record was completed on (mo/day/yr) 2/6/89 under the business name of Haldeman Well Drilling by (signature) Craig Hg