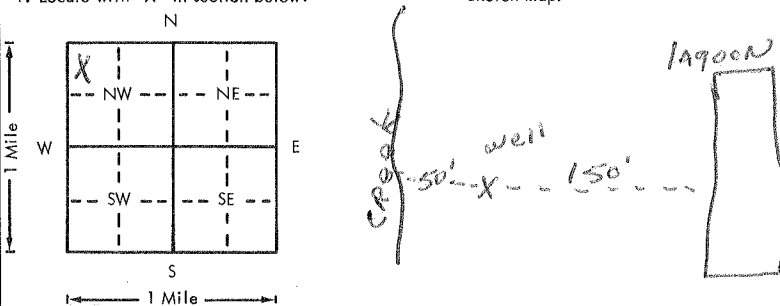


USE TYPEWRITER OR BALL POINT PEN—PRESS FIRMLY, PRINT CLEARLY.

WATER WELL RECORD  
KSA 82a-1201-1215

Kansas Department of Health and Environment—Division of Environment  
(Water well Contractors)  
Topeka, Kansas 66620

1. Location of well:	County <u>GEARY</u>	Fraction <u>NW 1/4 NW 1/4 NW 1/4</u>	Section number <u>12</u>	Township number <u>T 13 (S)</u>	Range number <u>R 7 (E/W)</u>
2. Distance and direction from nearest town or city: <u>9.5 SE OF</u> Street address of well location if in city: <u>JUNCTION CITY</u>			3. Owner of well: <u>F + R SWINE</u> R.R. or street: City, state, zip code: <u>PRI Dwight</u>		
4. Locate with "X" in section below: 			6. Bore hole dia. <u>10</u> in. Completion date _____ Well depth <u>50</u> ft. <u>4-3-78</u>		
5. Type and color of material			7. <input type="checkbox"/> Cable tool <input checked="" type="checkbox"/> Rotary <input type="checkbox"/> Driven <input type="checkbox"/> Dug <input type="checkbox"/> Hollow rod <input type="checkbox"/> Jetted <input type="checkbox"/> Bored <input type="checkbox"/> Reverse rotary		
			8. Use: <input type="checkbox"/> Domestic <input type="checkbox"/> Public supply <input type="checkbox"/> Industry <input type="checkbox"/> Irrigation <input type="checkbox"/> Air conditioning <input checked="" type="checkbox"/> Stock <input type="checkbox"/> Lawn <input type="checkbox"/> Oil field water <input type="checkbox"/> Other		
			9. Casing: Material <u>PVC</u> Height <u>Above</u> or below Threaded <input type="checkbox"/> Welded <input type="checkbox"/> Surface <u>10 FT</u> in. RMP <input type="checkbox"/> PVC <u>9L</u> Weight <u>2.58</u> lbs./ft. Dia. <u>5</u> in. to <u>30</u> ft. depth Wall Thickness: inches or Dia. _____ in. to _____ ft. depth Gauge No. <u>274</u>		
			10. Screen: Manufacturer's name <u>Pumpeco, MP</u> Type <u>PVC</u> Dia. <u>5</u> Slot/gauze <u>.020</u> Length <u>15</u> Set between <u>15</u> ft. and <u>30</u> ft. ft. and _____ ft. Gravel pack? <input checked="" type="checkbox"/> Size range of material: <u>0.30/0.60</u>		
			11. Static water level: _____ mo./day/yr. <u>10</u> ft. below land surface Date <u>4-3-78</u>		
			12. Pumping level below land surfaces: _____ ft. after _____ hrs. pumping _____ g.p.m. _____ ft. after _____ hrs. pumping _____ g.p.m. Estimated maximum yield <u>20</u> g.p.m.		
			13. Water sample submitted: _____ mo./day/yr. <input type="checkbox"/> Yes <input checked="" type="checkbox"/> No Date _____		
			14. Well head completion: <u>Cap</u> <input type="checkbox"/> Pitless adapter <u>10 FT</u> Inches above grade		
			15. Well grouted? <input checked="" type="checkbox"/> With: <input checked="" type="checkbox"/> Neat cement <input type="checkbox"/> Bentonite <input type="checkbox"/> Concrete Depth: From <u>0</u> ft. to <u>10</u> ft.		
			16. Nearest source of possible contamination: _____ ft. _____ Direction <u>E</u> Type <u>Lagoon</u> Well disinfected upon completion? <input checked="" type="checkbox"/> Yes <input type="checkbox"/> No		
			17. Pump: <input checked="" type="checkbox"/> Not installed Manufacturer's name _____ Model number _____ HP _____ Volts _____ Length of drop pipe _____ ft. capacity _____ g.p.m. Type: <input type="checkbox"/> Submersible <input type="checkbox"/> Turbine <input type="checkbox"/> Jet <input type="checkbox"/> Reciprocating <input type="checkbox"/> Centrifugal <input type="checkbox"/> Other		
			20. Water well contractor's certification: This well was drilled under my jurisdiction and this report is true to the best of my knowledge and belief. <u>Strader Dalg Co</u> <u>182</u> Business name License No. Address <u>RT 1 Holton, KS</u> Signed <u>Dale Asher</u> Date <u>4-11-78</u> Authorized representative		
18. Elevation:	19. Remarks: <u>OWNER TO INSTAL SLAB</u>				
Topography: <input type="checkbox"/> Hill <input type="checkbox"/> Slope <input type="checkbox"/> Upland <input checked="" type="checkbox"/> Valley					

Forward the white, blue and pink copies to the Department of Health and Environment

Form WWC-5

T 13 R 7 E W 12 Sec 12