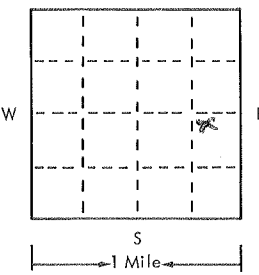
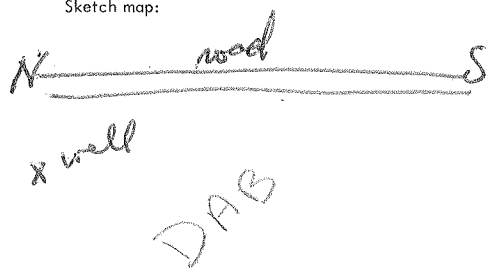


USE TYPEWRITER OR BALL POINT PEN-PRESS FIRMLY, PRINT CLEARLY.

WATER WELL RECORD
KSA 82a-1201-1215

T R EW sec 1/4 1/4 1/4 No.

Kansas State Dept. Of Health
(Water Well Contractors)
Forbes-Bldg. 740
Topeka, Kansas 66620

1 Location of well:	County Geary	Township name E. Liberty	Fraction Net of 8/4	Section number 31	Town number 7-13-5	Range number 8-E
Distance and direction from nearest town or city: 5 miles N.W. of Alta Vista				3 Owner of well: John H. Folk		
Street address of well location if in city:				Address: Rt 1 Alta Vista, Kans		
Locate with "X" in section below: 				Sketch map: 		
2 Type and color of material				From	To	4 Well depth: 65 ft. Date of completion 7-18-76 Well diameter 6 1/2 in.
clay				0	5	5 <input checked="" type="checkbox"/> Cable tool <input type="checkbox"/> Rotary <input type="checkbox"/> Driven <input type="checkbox"/> Dug <input type="checkbox"/> Hollow rod <input type="checkbox"/> Jetted <input type="checkbox"/> Bored <input type="checkbox"/> Reverse rotary
lime				5	16	6 Use: <input checked="" type="checkbox"/> Domestic <input type="checkbox"/> Public supply <input type="checkbox"/> Industry <input checked="" type="checkbox"/> Irrigation <input type="checkbox"/> Air conditioning <input type="checkbox"/> Commercial <input type="checkbox"/> Test well <input type="checkbox"/> Human
Hd Shale				16	21	7 Casing: Material RMP Height: above/below Threaded <input type="checkbox"/> Welded <input type="checkbox"/> Surface 18 in. Diam. 5" Weight _____ lbs./ft. _____ in. to 68 ft. depth Drive shoe? <input type="checkbox"/> Yes <input type="checkbox"/> No _____ in. to _____ ft. depth
lime				21	34	8 Screen: Manufacturer Sunflower Type RMP Dia. 5" Slot/gauze 3/32 Length 10' Set between 48 ft. and 68 ft. Fittings: Gravel pack <input checked="" type="checkbox"/> Yes <input type="checkbox"/> No Size range of material 4'
Hd Shale				34	53	9 Static water level: 33 ft. below land surface Date 7-18-76
						10 Pumping level below land surfaces: _____ ft. after _____ hrs. pumping _____ g.p.m. _____ ft. after _____ hrs. pumping _____ g.p.m. Estimated maximum yield 6 g.p.m.
						11 Water sample submitted: <input type="checkbox"/> Yes <input checked="" type="checkbox"/> No Date _____
						12 Well head completion: <input type="checkbox"/> Pitless adapter <input type="checkbox"/> Inches above grade NA
						13 Well grouted? <input checked="" type="checkbox"/> Yes <input type="checkbox"/> No <input type="checkbox"/> Neat cement <input type="checkbox"/> Bentonite <input type="checkbox"/> Concrete Depth: From 4 ft. to 17 ft.
						14 Nearest source of possible contamination: ft. 300' Direction SE Type Residence Well disinfected upon completion? <input checked="" type="checkbox"/> Yes <input type="checkbox"/> No
						15 Pump: <input type="checkbox"/> Not installed Manufacturer's name _____ Model number _____ HP _____ Volts _____ Length of drop pipe _____ ft. capacity _____ g.m.p. Type: <input type="checkbox"/> Submersible <input type="checkbox"/> Turbine <input type="checkbox"/> Jet <input type="checkbox"/> Reciprocating <input type="checkbox"/> Centrifugal <input type="checkbox"/> Other
16 Remarks: elevation Upland Gradual Slope to North				17 Water well contractor's certification: This well was drilled under my jurisdiction and this report is true to the best of my knowledge and belief. Moritz Drilling 120 Business name _____ License No. _____ Address Rt 4 Box 59 ge. Kans Signed F.W. Moritz Date 6-21- Authorized representative		