


1 LOCATION OF WATER WELL: County: **GEARY** Fraction: **SW 1/4 NE 1/4 NE 1/4** Section Number: **30** Township Number: **T 13 S** Range Number: **R 8 E**

Distance and direction from nearest town or city street address of well if located within city? **Dwight 2 miles east 3 1/4 north on east side of road**

2 WATER WELL OWNER: **Wm Brown**
RR#, St. Address, Box #: **Dwight Kansas 66849**
City, State, ZIP Code: **Dwight Kansas 66849**
Board of Agriculture, Division of Water Resources
Application Number:

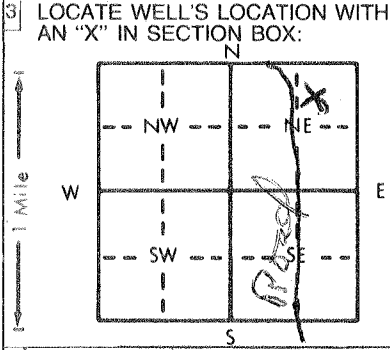

3 LOCATE WELL'S LOCATION WITH AN "X" IN SECTION BOX: [Diagram]
4 DEPTH OF COMPLETED WELL: **63** ft. ELEVATION:
Depth(s) Groundwater Encountered: **45 45** ft. 2. ft. 3. ft.
WELL'S STATIC WATER LEVEL: **45 45** ft. below land surface measured on mo/day/yr **Oct 15 1981**
Pump test data: Well water was ft. after hours pumping gpm
Est. Yield **1.0** gpm: Well water was ft. after hours pumping gpm
Bore Hole Diameter: **1.0** in. to **1.5** ft., and **6 1/2** in. to **63** ft.
WELL WATER TO BE USED AS:
 1 Domestic 3 Feedlot 6 Oil field water supply 9 Dewatering 12 Other (Specify below)
 2 Irrigation 4 Industrial 7 Lawn and garden only 10 Observation well
Was a chemical/bacteriological sample submitted to Department? Yes.....No ; If yes, mo/day/yr sample was submitted
Water Well Disinfected? Yes No

5 TYPE OF BLANK CASING USED:
1 Steel 2 PVC 3 RMP (SR) 4 ABS 5 Wrought iron 6 Asbestos-Cement 7 Fiberglass 8 Concrete tile 9 Other (specify below) 10 Asbestos-cement
Blank casing diameter: **5** in. to **63** ft., Dia. in. to ft., Dia. in. to ft.
Casing height above land surface: in., weight lbs./ft. Wall thickness or gauge No. **26 Wall**
TYPE OF SCREEN OR PERFORATION MATERIAL:
1 Steel 2 Brass 3 Stainless steel 4 Galvanized steel 5 Fiberglass 6 Concrete tile 7 PVC 8 RMP (SR) 9 ABS 10 Asbestos-cement
11 Other (specify) 12 None used (open hole)
SCREEN OR PERFORATION OPENINGS ARE:
1 Continuous slot 2 Louvered shutter 3 Mill slot 4 Key punched 5 Gauzed wrapped 6 Wire wrapped 7 Torch cut 8 Saw cut 9 Drilled holes 10 Other (specify) 11 None (open hole)
SCREEN-PERFORATED INTERVALS: From **63** ft. to **23** ft., From ft. to ft.
GRAVEL PACK INTERVALS: From **63** ft. to **15** ft., From ft. to ft.

6 GROUT MATERIAL: 1 Neat cement 2 Cement grout 3 Bentonite 4 Other
Grout Intervals: From **15** ft. to **5** ft., From ft. to ft.
What is the nearest source of possible contamination:
1 Septic tank 2 Sewer lines 3 Watertight sewer lines 4 Lateral lines 5 Cess pool 6 Seepage pit 7 Pit privy 8 Sewage lagoon 9 Feedyard 10 Livestock pens 11 Fuel storage 12 Fertilizer storage 13 Insecticide storage 14 Abandoned water well 15 Oil well/Gas well 16 Other (specify below) **Cow lot**
Direction from well? **north** How many feet? **105**

FROM	TO	LITHOLOGIC LOG	FROM	TO	LITHOLOGIC LOG
		old well casings pulled out & cleaned well + new casings installed			

7 CONTRACTOR'S OR LANDOWNER'S CERTIFICATION: This water well was (1) constructed, (2) reconstructed, or (3) plugged under my jurisdiction and was completed on (mo/day/year) **Oct 15 - 1981** and this record is true to the best of my knowledge and belief. Kansas Water Well Contractor's License No. **237**. This Water Well Record was completed on (mo/day/year) **Oct 16 - 1981** under the business name of **Strader Drilling Co** by (signature) **Harold Strader**
INSTRUCTIONS: Use typewriter or ball point pen, PLEASE PRESS FIRMLY and PRINT clearly. Please fill in blanks, underline or circle the correct answers. Send to three copies to Kansas Department of Health and Environment, Division of Environment, Environmental Geology Section, Topeka, KS 66620. Send one to WATER WELL OWNER and retain one for your records.