


1 LOCATION OF WATER WELL: County: Wabawunsee Fraction: SE 1/4 SE 1/4 SW 1/4 Section Number: 7 Township Number: T 13 S Range Number: R 9E EW

Distance and direction from nearest town or city street address of well if located within city?
3 No. 1 East 1/2 East North side road from Alta Vista

2 WATER WELL OWNER: Mayer Ranch
 RR#, St. Address, Box #: Rt. 1 Box 109
 City, State, ZIP Code: Alta Vista, KS, 66834
 Board of Agriculture, Division of Water Resource
 Application Number:

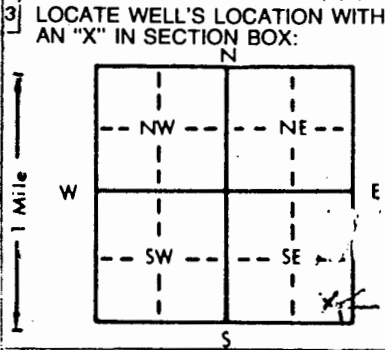

4 DEPTH OF COMPLETED WELL: 96 ft. ELEVATION: _____ ft.
 Depth(s) Groundwater Encountered: 1. 58 ft. 2. _____ ft. 3. _____ ft.
 WELL'S STATIC WATER LEVEL: 37 ft. below land surface measured on mo/day/yr 10-5-93
 Pump test data: Well water was 70 ft. after 3 hours pumping 32 gpm
 Est. Yield 30 gpm: Well water was _____ ft. after _____ hours pumping _____ gpm
 Bore Hole Diameter: 8" in. to 96 ft., and _____ in. to _____ ft.
 WELL WATER TO BE USED AS:
 1 Domestic 3 Feedlot 6 Oil field water supply 9 Dewatering 12 ~~Other (Specify below)~~
 2 Irrigation 4 Industrial 7 Lawn and garden only 10 Monitoring well Livestock
 Was a chemical/bacteriological sample submitted to Department? Yes _____ No _____; If yes, mo/day/yr sample was submitted _____
 Water Well Disinfected? Yes X No _____

5 TYPE OF BLANK CASING USED:
 1 Steel 3 RMP (SR) 5 Wrought iron 8 Concrete tile CASING JOINTS: Glued X Clamped _____
 2 Brass 4 Galvanized steel 6 Asbestos-Cement 9 Other (specify below) Welded _____
2 PVC SDR-26 4 ABS 7 Fiberglass _____ Threaded _____
 Blank casing diameter: 5 in. to 60 ft., Dia. _____ in. to _____ ft., Dia. _____ in. to _____ ft.
 Casing height above land surface: 16 in., weight SDR-26 lbs./ft. Wall thickness or gauge No. _____
 TYPE OF SCREEN OR PERFORATION MATERIAL:
 1 Steel 3 Stainless steel 5 Fiberglass 8 RMP (SR) 10 Asbestos-cement 11 Other (specify) _____
 2 Brass 4 Galvanized steel 6 Concrete tile 9 ABS 12 None used (open hole)
 SCREEN OR PERFORATION OPENINGS ARE:
 1 Continuous slot 3 Mill slot 5 Gauzed wrapped 8 Saw cut 11 None (open hole)
 2 Louvered shutter 4 Key punched 6 Wire wrapped 9 Drilled holes
 7 Torch cut 10 Other (specify) _____
 SCREEN-PERFORATED INTERVALS: From 60 ft. to 96 ft., From _____ ft. to _____ ft.
 GRAVEL PACK INTERVALS: From 60 ft. to 96 ft., From _____ ft. to _____ ft.

6 GROUT MATERIAL: 1 Neat cement 2 Cement grout 3 Bentonite 4 Other _____
 Grout Intervals: From 3 ft. to 36 ft., From _____ ft. to _____ ft.
 What is the nearest source of possible contamination:
1 Septic tank 4 Lateral lines 7 Pit privy 10 Livestock pens 14 Abandoned water well
 2 Sewer lines 5 Cess pool 8 Sewage lagoon 11 Fuel storage 15 Oil well/Gas well
 3 Watertight sewer lines 6 Seepage pit 9 Feedyard 12 Fertilizer storage 16 Other (specify below) _____
 Direction from well? South How many feet? 1-mile

FROM	TO	LITHOLOGIC LOG	FROM	TO	PLUGGING INTERVALS
0	2	Top soil			
2	32	yellow limestone			
32	36	Blue shale			
36	45	Hard gray-Tan limestone			
45	62	Tan limestone			
62	74	gray shale			
74	87	Red shale			
87	89	Hard gray limestone			
89	94	gray lime layered			
94	96	Blue shale			

RECEIVED
 JUL 13 1994
 BUREAU OF WATER

7 CONTRACTOR'S OR LANDOWNER'S CERTIFICATION: This water well was 1 constructed, (2) reconstructed, or (3) plugged under my jurisdiction and was completed on (mo/day/year) 10-5-93 and this record is true to the best of my knowledge and belief. Kansas Water Well Contractor's License No. 513 This Water Well Record was completed on (mo/day/yr) 10-19-93 under the business name of H2O Drilling Service by (signature) Nancy Schreiber

INSTRUCTIONS: Use typewriter or ball point pen. PLEASE PRESS FIRMLY and PRINT clearly. Please fill in blanks, underline or circle the correct answer. Send top three copies to Kansas Department of Health and Environment, Bureau of Water, Topeka, Kansas 66620-0001. Telephone: 913-296-5545. Send one to WATER WELL OWNER and retain one for your records.

577