


1 LOCATION OF WATER WELL: Fraction SW 1/4 NW 1/4 SW 1/4 Section Number 29 Township Number T 14 S Range Number R 1 **EW***
 County: Dickinson

Distance and direction from nearest town or city street address of well if located within city?
8 1/2 miles South of Solomon, Ks & 1 mile East

2 WATER WELL OWNER: Gary Griffitt
 RR#, St. Address, Box # : 1432 Barn Rd. Board of Agriculture, Division of Water Resources
 City, State, ZIP Code : Solomon, Kansas 67480 Application Number:

3 LOCATE WELL'S LOCATION WITH AN "X" IN SECTION BOX:

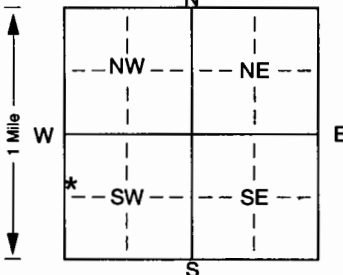

4 DEPTH OF COMPLETED WELL: 45 ft. ELEVATION: ft.
 Depth(s) Groundwater Encountered 1 37 ft. 2. ft. 3. ft.
 WELL'S STATIC WATER LEVEL 20 ft. below land surface measured on mo/day/yr 8 / 17 / 00
 Pump test data: Well water was ft. after hours pumping gpm
 Est. Yield 15+ gpm: Well water was ft. after hours pumping gpm
 Bore Hole Diameter 9 in. to 45 ft., and in. to ft.
 WELL WATER TO BE USED AS: 5 Public water supply 8 Air conditioning 11 Injection well
1 Domestic 3 Feedlot 6 Oil field water supply 9 Dewatering 12 Other (Specify below)
2 Irrigation 4 Industrial 7 Domestic (lawn & garden) 10 Monitoring well
 Was a chemical/bacteriological sample submitted to Department? Yes. No. *; If yes, mo/day/yr sample was submitted
 Water Well Disinfected? Yes * No

5 TYPE OF BLANK CASING USED: 5 Wrought iron 8 Concrete tile CASING JOINTS: Glued. * Clamped.
1 Steel 3 RMP (SR) 6 Asbestos-Cement 9 Other (specify below) Welded
2 PVC 4 ABS 7 Fiberglass Threaded.....
 Blank casing diameter 5 in. to 45 ft., Dia in. to ft., Dia in. to ft.
 Casing height above land surface 12 in., weight 160 lbs./ft. Wall thickness or gauge No. 214
 TYPE OF SCREEN OR PERFORATION MATERIAL: 7 PVC 10 Asbestos-cement
1 Steel 3 Stainless steel 5 Fiberglass 8 RMP (SR) 11 Other (specify)
2 Brass 4 Galvanized steel 6 Concrete tile 9 ABS 12 None used (open hole)
 SCREEN OR PERFORATION OPENINGS ARE: 5 Gauzed wrapped 8 Saw cut 11 None (open hole)
1 Continuous slot 3 Mill slot 6 Wire wrapped 9 Drilled holes
2 Louvered shutter 4 Key punched 7 Torch cut 10 Other (specify) ft.
 SCREEN-PERFORATED INTERVALS: From 25 ft. to 45 ft., From ft. to ft.
 From ft. to ft., From ft. to ft.
 GRAVEL PACK INTERVALS: From 20 ft. to 45 ft., From ft. to ft.
 From ft. to ft., From ft. to ft.

6 GROUT MATERIAL: 1 Neat cement 2 Cement grout 3 Bentonite 4 Other
 Grout Intervals: From 0 ft. to 20 ft., From ft. to ft., From ft. to ft.
 What is the nearest source of possible contamination:
1 Septic tank 4 Lateral lines 7 Pit privy 10 Livestock pens 14 Abandoned water well
2 Sewer lines 5 Cess pool 8 Sewage lagoon 11 Fuel storage 15 Oil well/Gas well
3 Watertight sewer lines 6 Seepage pit 9 Feedyard 12 Fertilizer storage 16 Other (specify below)
 13 Insecticide storage
 Direction from well? EAST APPROX How many feet? 500

FROM	TO	LITHOLOGIC LOG	FROM	TO	PLUGGING INTERVALS
0	7	DARK TOP SOIL CLAY			
7	11	BROWN CLAY			
11	13	TAN CLAY LITE COLOR			
13	14	GRAY SHALEY CLAY			
14	15	RED SHALEY CLAY			
15	17	LITE GRAY SHALEY CLAY			
17	19	LITE COLOR SHALEY CLAY			
19	21	DARK GRAY SHALE & CLAY			
21	23	LITE GRAY CLAY & SHALE			
23	25	DARK GRAY CLAY & SHALE			
25	27	LITE COLOR SHALE			
27	32	DARK SHALE & CLAY			
32	37	HARD GRAY SHALE			
37	45	GYPSUM ROCK & GRAY SHALE			

7 CONTRACTOR'S OR LANDOWNER'S CERTIFICATION: This water well was (1) constructed, (2) reconstructed, or (3) plugged under my jurisdiction and was completed on (mo/day/year) 8 / 17 / 00 and this record is true to the best of my knowledge and belief. Kansas Water Well Contractor's Licence No. 397 This Water Well Record was completed on (mo/day/yr) 8 / 23 / 00 under the business name of CENTRAL KANSAS DRILLING by (signature) Harold D. Martin