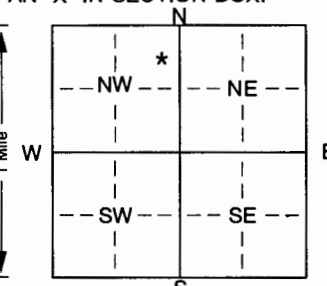


1 LOCATION OF WATER WELL: Fraction NE 1/4 NE 1/4 NW 1/4 Section Number 2 Township Number T 14 S R 1 Range Number EW\*  
 County: Dickinson  
 Distance and direction from nearest town or city street address of well if located within city?  
3 miles South of Abilene, Ks on Hwy 15 to 1900 Ave & go West 3 1/2 miles

2 WATER WELL OWNER: Doug Gfeller  
 RR#, St. Address, Box # : 536 1900 Ave Board of Agriculture, Division of Water Resources  
 City, State, ZIP Code : Abilene, Kansas 67410 Application Number:

3 LOCATE WELL'S LOCATION WITH AN "X" IN SECTION BOX:  DEPTH OF COMPLETED WELL: 5.1 ft. ELEVATION: .....  
 Depth(s) Groundwater Encountered 1.....35.....ft. 2.....ft. 3.....ft.  
 WELL'S STATIC WATER LEVEL .....23.....ft. below land surface measured on mo/day/yr 5./.25./.01.....  
 Pump test data: Well water was .....ft. after ..... hours pumping ..... gpm  
 Est. Yield .....1.5±.....gpm: Well water was .....ft. after ..... hours pumping ..... gpm  
 Bore Hole Diameter .....9.....in. to .....5.1.....ft., and.....in. to .....ft.  
 WELL WATER TO BE USED AS: 5 Public water supply 8 Air conditioning 11 Injection well  
 1 Domestic 3 Feedlot 6 Oil field water supply 9 Dewatering 12 Other (Specify below)  
 2 Irrigation 4 Industrial 7 Domestic (lawn & garden) 10 Monitoring well .....  
 Was a chemical/bacteriological sample submitted to Department? Yes..... No...\*...; If yes, mo/day/yrs sample was submitted  
 Water Well Disinfected? Yes \* No

5 TYPE OF BLANK CASING USED: 5 Wrought iron 8 Concrete tile CASING JOINTS: Glued...\*...Clamped.....  
 1 Steel 3 RMP (SR) 6 Asbestos-Cement 9 Other (specify below) Welded.....  
 2 PVC 4 ABS 7 Fiberglass Threaded.....  
 Blank casing diameter .....5.....in. to .....5.1.....ft., Dia .....in. to .....ft., Dia .....in. to .....ft.  
 Casing height above land surface. .2.4.....in., weight .....1.60.....lbs./ft. Wall thickness or gauge No. .2.14.....  
 TYPE OF SCREEN OR PERFORATION MATERIAL: 7 PVC 10 Asbestos-cement  
 1 Steel 3 Stainless steel 5 Fiberglass 8 RMP (SR) 11 Other (specify) .....  
 2 Brass 4 Galvanized steel 6 Concrete tile 9 ABS 12 None used (open hole)  
 SCREEN OR PERFORATION OPENINGS ARE: 5 Gauzed wrapped 8 Saw cut 11 None (open hole)  
 1 Continuous slot 3 Mill slot 6 Wire wrapped 9 Drilled holes  
 2 Louvered shutter 4 Key punched 7 Torch cut 10 Other (specify) .....ft.  
 SCREEN-PERFORATED INTERVALS: From.....48.....ft. to .....5.1.....ft., From .....ft. to.....ft.  
 From.....ft. to .....ft., From .....ft. to.....ft.  
 GRAVEL PACK INTERVALS: From.....23.....ft. to .....5.1.....ft., From .....ft. to.....ft.  
 From.....ft. to .....ft., From .....ft. to.....ft.

6 GROUT MATERIAL: 1 Neat cement 2 Cement grout 3 Bentonite 4 Other .....  
 Grout Intervals: From...0.....ft. to ...23.....ft., From .....ft. to.....ft., From .....ft. to.....ft.  
 What is the nearest source of possible contamination:  
 1 Septic tank 4 Lateral lines 7 Pit privy 10 Livestock pens 14 Abandoned water well  
 2 Sewer lines 5 Cess pool 8 Sewage lagoon 11 Fuel storage 15 Oil well/Gas well  
 3 Watertight sewer lines 6 Seepage pit 9 Feedyard 12 Fertilizer storage 16 Other (specify below)  
 13 Insecticide storage .....  
 Direction from well? SOUTH How many feet? 83

FROM	TO	LITHOLOGIC LOG	FROM	TO	PLUGGING INTERVALS
0	3	DARK TOP SOIL			
3	12	BROWN CLAY			
12	16	FINE SAND			
16	35	DARK CLAY			
35	45	FINE SAND			
45	51	SAND 1 1/8			

7 CONTRACTOR'S OR LANDOWNER'S CERTIFICATION: This water well was (1) constructed, (2) reconstructed, or (3) plugged under my jurisdiction and was completed on (mo/day/year) 5 / 25 / 01 ..... and this record is true to the best of my knowledge and belief. Kansas Water Well Contractor's Licence No. ....397..... This Water Well Record was completed on (mo/day/yr) 5./.28./.01.....  
 under the business name of CENTRAL KANSAS DRILLING by (signature) Harold D. Martin