


WATER WELL RECORD Form WWC-5 KSA 82a-1212

1 LOCATION OF WATER WELL: Fraction NE 1/4 NE 1/4 NE 1/4 Section Number 25 Township Number T 14 S Range Number R 11 E/W

County: WABAUNSEE
 Distance and direction from nearest town or city street address of well if located within city?
3 miles south, 2 1/4 west of Eskridge

2 WATER WELL OWNER: Tom Gardner
 RR#, St. Address, Box # : 5009 E. Long View Rd. Board of Agriculture, Division of Water Resources
 City, State, ZIP Code : Kansas City, MO 64137 Application Number:

3 LOCATE WELL'S LOCATION WITH AN "X" IN SECTION BOX:

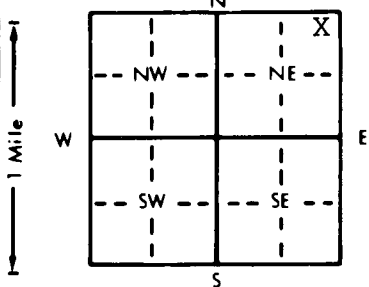

4 DEPTH OF COMPLETED WELL: 180' ft. ELEVATION:
 Depth(s) Groundwater Encountered 1. 53' ft. 2. ft. 3. ft.
 WELL'S STATIC WATER LEVEL 60' ft. below land surface measured on mo/day/yr 08/26/98
 Pump test data: Well water was ft. after hours pumping gpm
 Est. Yield 1 gpm: Well water was ft. after hours pumping gpm
 Bore Hole Diameter: 8 3/4 in. to ft., and in. to ft.
 WELL WATER TO BE USED AS: 5 Public water supply 8 Air conditioning 11 Injection well
 1 Domestic 3 Feedlot 6 Oil field water supply 9 Dewatering 12 Other (Specify below)
 2 Irrigation 4 Industrial 7 Lawn and garden only 10 Monitoring well
 Was a chemical/bacteriological sample submitted to Department? Yes No X; If yes, mo/day/yr sample was submitted
 Water Well Disinfected? Yes X No

5 TYPE OF BLANK CASING USED: 5 Wrought iron 8 Concrete tile CASING JOINTS: Glued X Clamped
 1 Steel 3 RMP (SR) 6 Asbestos-Cement 9 Other (specify below) Welded
 2 PVC 4 ABS 7 Fiberglass Threaded
 Blank casing diameter 5" in. to 0-40 ft., Dia. 5" in. to 80-100 ft., Dia. 5" in. to 120-180 ft.
 Casing height above land surface 24" in., weight 2.82 lbs./ft. Wall thickness or gauge No. .258
 TYPE OF SCREEN OR PERFORATION MATERIAL: 7 PVC 10 Asbestos-cement
 1 Steel 3 Stainless steel 5 Fiberglass 8 RMP (SR) 11 Other (specify)
 2 Brass 4 Galvanized steel 6 Concrete tile 9 ABS 12 None used (open hole)
 SCREEN OR PERFORATION OPENINGS ARE: 5 Gauzed wrapped 8 Saw cut 11 None (open hole)
 1 Continuous slot 3 Mill slot 6 Wire wrapped 9 Drilled holes
 2 Louvered shutter 4 Key punched 7 Torch cut 10 Other (specify)
 SCREEN-PERFORATED INTERVALS: From 40 ft. to 80 ft., From ft. to ft.
 From 100 ft. to 120 ft., From ft. to ft.
 GRAVEL PACK INTERVALS: From 24 ft. to 180 ft., From ft. to ft.
 From ft. to ft., From ft. to ft.

6 GROUT MATERIAL: 1 Neat cement 2 Cement grout 3 Bentonite 4 Other
 Grout Intervals: From 4 ft. to 24 ft., From ft. to ft., From ft. to ft.
 What is the nearest source of possible contamination:
 1 Septic tank 4 Lateral lines 7 Pit privy 10 Livestock pens 14 Abandoned water well
 2 Sewer lines 5 Cess pool 8 Sewage lagoon 11 Fuel storage 15 Oil well/Gas well
 3 Watertight sewer lines 6 Seepage pit 9 Feedyard 12 Fertilizer storage 16 Other (specify below)
 13 Insecticide storage
 Direction from well? SW How many feet? 100'

FROM	TO	LITHOLOGIC LOG	FROM	TO	PLUGGING INTERVALS
0	2	Limestone-loose	92	104	Shaley LS-Grey
2	5	Clay-Brown	104	115	Limestone-Tan
5	16	Shale-Yellow	115	126	Shale-Grey
16	23	Limestone-Yellow	126	131	Limestone-Grey
23	27	Shaley LS-Yellow	131	142	Shaley LS-Grey
27	28	Shale-Red	142	158	Gyp
28	29	Shale-Yellow	158	161	Limestone-Grey
29	38	Shale-Grey	161	163	Shale-Grey
38	41	Limestone-Yellow	163	167	Limestone-Grey
41	50	Shale-Grey	167	180	Shale-Grey
50	53	Limestone-Yellow			
53	58	Shale-Grey			
58	64	Limestone-Tan			
64	77	Shaley LS-Grey			
77	92	Limestone-Tan			

7 CONTRACTOR'S OR LANDOWNER'S CERTIFICATION: This water well was (1) constructed, (2) reconstructed, or (3) plugged under my jurisdiction and was completed on (mo/day/year) 08/26/98 and this record is true to the best of my knowledge and belief. Kansas Water Well Contractor's License No. 182 This Water Well Record was completed on (mo/day/yr) 10-9-98 under the business name of STRADER DRILLING CO., INC. by (signature) Dale Jackson

INSTRUCTIONS: Use typewriter or ball point pen. PLEASE PRESS FIRMLY and PRINT clearly. Please fill in blanks, underline or circle the correct answers. Send top three copies to Kansas Department of Health and Environment, Bureau of Water, Topeka, Kansas 66620-0001. Telephone: 913-296-5545. Send one to WATER WELL OWNER and retain one for your records.

OFFICE USE ONLY
T
R
EW
SEC
1/4
1/4
1/4