

## WATER WELL RECORD

Form WWC-5

KSA 82a-1212 ID No. \_\_\_\_\_

1 LOCATION OF WATER WELL:	Fraction	Section Number	Township Number	Range Number
---------------------------	----------	----------------	-----------------	--------------

County: Wabaunsee NE  $\frac{1}{4}$  NE  $\frac{1}{4}$  NW  $\frac{1}{4}$  18 T 14 S R 12E E/W

Distance and direction from nearest town or city street address of well if located within city?

3/4 mile west 1 3/8 miles south of Eskridge

2 WATER WELL OWNER: Jim Hinck


RR#, St. Address, Box # : Box 144

City, State, ZIP Code : Eskridge, Ks. 66423

Board of Agriculture, Division of Water Resources  
Application Number: \_\_\_\_\_

3 LOCATE WELL'S LOCATION WITH 4 DEPTH OF COMPLETED WELL. . . 80 ft. ELEVATION: . . . . .

AN "X" IN SECTION BOX:

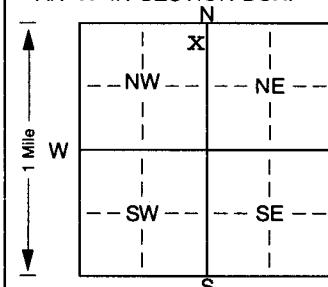

Depth(s) Groundwater Encountered 1. . . . . ft. 2. . . . . ft. 3. . . . . ft.

WELL'S STATIC WATER LEVEL . . . 14 . . . ft. below land surface measured on mo/day/yr . . . 9-26-2001 . . .

Pump test data: Well water was . . . . . ft. after . . . . . hours pumping . . . . . gpm

Est. Yield . . . 4 . . . gpm: Well water was . . . . . ft. after . . . . . hours pumping . . . . . gpm

Bore Hole Diameter. . . 8. 3/4 . . . in. to . . . . . ft., and. . . . . in. to . . . . . ft.

WELL WATER TO BE USED AS: 5 Public water supply 8 Air conditioning 11 Injection well

1 Domestic 3 Feedlot 6 Oil field water supply 9 Dewatering 12 Other (Specify below)

2 Irrigation 4 Industrial 7 Domestic (lawn & garden) 10 Monitoring well . . . . .

Was a chemical/bacteriological sample submitted to Department? Yes. . . . . No. . . . . X. . . . . If yes, mo/day/yr sample was submitted

Water Well Disinfected? Yes X No

5 TYPE OF BLANK CASING USED: 5 Wrought iron 8 Concrete tile Casing JOINTS: Glued. . . X . . . Clamped. . . . .

1 Steel 3 RMP (SR) 6 Asbestos-Cement 9 Other (specify below) Welded. . . . .

2 PVC 4 ABS 7 Fiberglass . . . . . Threaded. . . . .

Blank casing diameter . . . 5 . . . . . in. to . . . . . ft., Dia . . . . . in. to . . . . . ft., Dia . . . . . in. to . . . . . ft.

Casing height above land surface. . . 36 . . . . . in., weight . . . . . 2.82 . . . . . lbs./ft. Wall thickness or gauge No. . . . . 258 . . . . .

TYPE OF SCREEN OR PERFORATION MATERIAL: 7 PVC 10 Asbestos-cement

1 Steel 3 Stainless steel 5 Fiberglass 8 RMP (SR) 11 Other (specify) . . . . .

2 Brass 4 Galvanized steel 6 Concrete tile 9 ABS 12 None used (open hole) . . . . .

SCREEN OR PERFORATION OPENINGS ARE: 5 Gauzed wrapped 8 Saw cut 11 None (open hole)

1 Continuous slot 3 Mill slot 6 Wire wrapped 9 Drilled holes . . . . .

2 Louvered shutter 4 Key punched 7 Torch cut 10 Other (specify) . . . . . ft.

SCREEN-PERFORATED INTERVALS: From. . . 15 . . . ft. to . . . 55 . . . ft., From. . . . . ft. to. . . . . ft.

From. . . 78 . . . ft. to . . . 80 . . . ft., From. . . . . ft. to. . . . . ft.

GRAVEL PACK INTERVALS: From. . . 13 . . . ft. to . . . 80 . . . ft., From. . . . . ft. to. . . . . ft.

From. . . . . ft. to. . . . . ft., From. . . . . ft. to. . . . . ft.

6 GROUT MATERIAL: 1 Neat cement 2 Cement grout 3 Bentonite 4 Other . . . . .

Grout Intervals: From. . . 0 . . . ft. to. . . 13 . . . ft., From. . . . . ft. to. . . . . ft., From. . . . . ft. to. . . . . ft.

What is the nearest source of possible contamination: 10 Livestock pens 14 Abandoned water well

1 Septic tank 4 Lateral lines 7 Pit privy 11 Fuel storage 15 Oil well/Gas well


2 Sewer lines 5 Cess pool 8 Sewage lagoon 12 Fertilizer storage 16 Other (specify below)

3 Watertight sewer lines 6 Seepage pit 9 Feedyard 13 Insecticide storage . . . . .

Direction from well? West How many feet? 150

FROM	TO	LITHOLOGIC LOG	FROM	TO	PLUGGING INTERVALS
0	2	top soil	70	73	tan limestone
2	7	brown clay	73	80	grey shaly limestone
7	8	yellow shale			
8	13	yellow loose limestone			
13	17	yellow shale			
17	23	grey shale			*permission to shallow grout
23	30	grey limestone			from Don Taylor 10-01-01
30	34	tan loose shaly limestone			
34	38	red shale			
38	39	grey limestone			
39	45	grey shale			
45	49	tan loose limestone			
49	64	grey shale			
64	70	grey shaly limestone			

7 CONTRACTOR'S OR LANDOWNER'S CERTIFICATION: This water well was (1) constructed, (2) reconstructed, or (3) plugged under my jurisdiction and was completed on (mo/day/year) . . . 9-26-2001 . . . and this record is true to the best of my knowledge and belief. Kansas

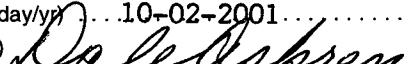Water Well Contractor's Licence No. . . . . 182 . . . . . This Water Well Record was completed on (mo/day/year) . . . 10-02-2001 . . . . . under the business name of Strader Drilling Co., Inc. by (signature) 

INSTRUCTIONS: Use typewriter or ball point pen. PLEASE PRESS FIRMLY and PRINT clearly. Please fill in blanks, underline or circle the correct answers. Send top three copies to Kansas Department of Health and Environment, Bureau of Water, Topeka, Kansas 66620-0001. Telephone 785-296-5524. Send one to WATER WELL OWNER and retain one for your records. Fee of \$5.00 for each constructed well.