


WEST

1	LOCATION OF WATER WELL:	Fraction	Section	Number	Township	Number	Range	Number
	County: <u>WA BARNES</u>	<u>W 1/2 N.W. 1/4</u>		<u>5</u>		<u>14</u>		<u>12E</u>

Distance and direction from nearest town or city street address of well if located within city?
1/2 N.W. OF Eskridge, KS

2	WATER WELL OWNER:	RR #, St. Address, Box #:	Board of Agriculture, Division of Water Resources
	<u>DALE RICE</u>	<u>18744 HIGHWAY</u>	Application Number:
	City, State, ZIP Code :	<u>ESKRIDGE, KS 66423</u>	

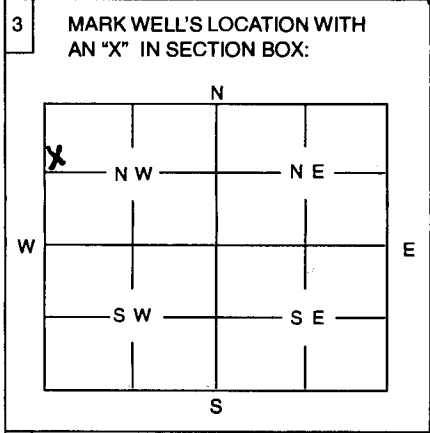

4	DEPTH OF WELL	<u>15</u>	ft
	WELL'S STATIC WATER LEVEL	<u>8</u>	ft.
	WELL WAS USED AS:		
	1 Domestic	5 Public Water Supply	9 Dewatering
	2 Irrigation	6 Oil Field Water Supply	10 Monitoring Well
	<input checked="" type="checkbox"/> 3 Feedlot	7 Domestic (Lawn & Garden)	11 Injection Well
	4 Industrial	8 Air Conditioning	12 Other
	Was a chemical / bacteriological sample submitted to Department? Yes	No <input checked="" type="checkbox"/>	
	If yes, mo/day/yr sample was submitted		
	Water Well Disinfected: Yes <input checked="" type="checkbox"/>	No	

5	TYPE OF BLANK CASING USED:
	1 Steel 3 RMP (SR) 5 Wrought 7 Fiberglass <input checked="" type="checkbox"/> Other (Specify below) <u>ROCK</u>
	2 PVC 4 ABS 6 Asbestos-Cement 8 Concrete Tile
	Blank casing diameter in. Was casing pulled? Yes No If yes, how much
	Casing height above or below land surface in.

6	GROUT PLUG MATERIAL:	1 Neat cement	2 Cement grout	<input checked="" type="checkbox"/> Bentonite	4 Other
	Grout Plug Intervals:	From ft. to ft.,	From ft. to ft.,	From ft. to ft.,	From ft. to ft.
	What is the nearest source of possible contamination:				
	1 Septic tank	6 Seepage pit	11 Fuel storage	16 Other (specify below)	
	2 Sewer lines	7 Pit privy	12 Fertilizer storage	<u>None</u>	
	3 Watertight sewer lines	8 Sewage lagoon	13 Insecticide storage		
	4 Lateral lines	9 Feedyard	14 Abandoned water well		
	5 Cess Pool	10 Livestock pens	15 Oil well/Gas well		
	Direction from well?	How many feet?			

FROM	TO	PLUGGING MATERIALS
<u>15 FT</u>	<u>6 FT</u>	<u>GRAVEL</u>
<u>6 FT</u>	<u>5 FT</u>	<u>DIRT</u>
<u>5 FT</u>	<u>4 1/2 FT</u>	<u>BENTONITE</u>
<u>4 1/2 FT</u>	<u>TOP</u>	<u>DIRT</u>

7	CONTRACTOR'S OR LANDOWNER'S CERTIFICATION: This water well was plugged under my jurisdiction and was completed on (mo/day/year) <u>8-8-02</u> and this record is true to the best of my knowledge and belief. Kansas Water Well Contractor's License No. <u>8-18-02</u> This Water Well Record was completed on (mo/day/year) <u>8-18-02</u> under the business name of <u>JOHN'S DOZER SERVICE</u> by (signature) <u>[Signature]</u>
---	---

INSTRUCTIONS: Use typewriter or ball point pen. Please press firmly and print clearly. Please fill in blanks, underline or circle the correct answers. Send top three copies to Kansas Department of Health and Environment, Bureau of Water, Topeka, Kansas 66620-0001. Telephone: 785/296-3565. Send one to Water Well Owner and retain one for your records.